

F 35

6-9-62

WATER WELL DRILLERS LOG

CODED

HERNDON WELL & SUPPLY CO.

Date: Jun 9, 1962, Driller: SHANNON, MISSISSIPPI, County Monroe

P. O. BOX 42

(Name)

G. TAYLOR

(1) Owner of Land:	Description & Color of Materials Sand, Clay, Red Clay, Shell, etc.	Thick- ness Feet	Depth Feet
<i>Changed</i> (Name) <u>Macey White</u> (Address) <u>Rt 1 Okolona, Miss.</u>	<u>Sand &amp; clay</u>		<u>0</u>
(2) Location: <u>NWNW NW</u> <u>12 135</u> <u>1/4, 1/4, Sec 2 T R 6E</u>	<u>Blue rock</u>		<u>25</u>
<u>1</u> miles <u>W</u> of <u>Winn</u> (distance) (direction) (Nearest Town)	<u>Gravel</u>		<u>125</u>
(3) Topography: <u>Hilly</u> (Hilly) (Flat) (Level)	<u>Gravel</u>		
(4) Purpose of Well: <u>Domestic</u> (Domestic Irrigation Municipal, Industrial, Other)	<u>Bottom</u>		<u>240</u>

Information upon completion of well:

(1) Diameter 4 inches.

(2) Total Depth 240 feet.

(3) Water Level 100 feet below top of ground.

(4) Cased to 28' 8" 4" Size 4"

(5) Screen: Size \_\_\_\_\_, Length \_\_\_\_\_

(6) Were any formations sealed against pollution?


yes,  no.

If YES depth of formation 25'

Why Gravel & Sand

Drillers Remarks:

CODED

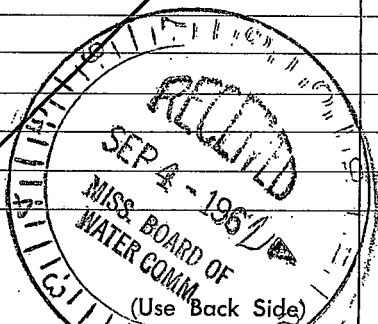

[The page contains extremely faint and illegible text, likely bleed-through from the reverse side of the document. No specific words or phrases can be discerned.]