

MISSISSIPPI  
 BOARD OF WATER COMMISSIONERS  
 416 North State Street  
 Jackson, Mississippi 39201

**CODED**

WATER WELL DRILLERS LOG  
 Herndon-Homan Well & Supply, Inc.

P. O. Box 42

Monroe

MONROE  
 F39  
 4-6-72

4-6-72  
 date well completed

1972

PLANNED MISSISSIPPI 38808 county well located

LANDOWNER:

Hubert Red  
 R 3, Aberdeen Misc  
 (mailing address)

description of formations  
 encountered

from

to

Surface sand & clay	0	25
Blue clay	25	26
Sand	26	40
Bottom	40	

WELL LOCATION:

sec 27 T 13 N R 6 E  
 S  
6 miles NW of Aberdeen  
 (distance) (direction) (nearest town)

WELL PURPOSE: Home  
 (home, irrigation, municipal, industrial)

WELL COMPLETION DATA:

- diameter (inches) 5
- total depth (feet) 400
- static water level (feet) 82 below above top of ground.
- casing Steel 30'  
 (material) (depth)  
5 if telescope see back.  
 (size)
- screen 20 5  
 (length) (depth to top)  
 (size) (material)
- pump 1/2 5  
 (HP) (yield gpm)  
electron  
 (type power)
- electric log NO  
 (yes or no)  
 (organization running log)
- how well bottom plugged open

**CODED**


DRILLERS REMARKS:

ADD 13 1972

MISS. DE. OF  
 MEMBER

If well telescopes please sketch and show depths.

GROUND LEVEL

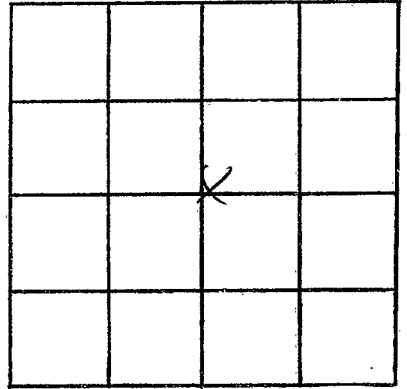

SECTION 27

Please indicate well location X.

ADDITIONAL INFORMATION

If more than one screen,  
show locations of each on sketch.