

MONROE

F40

4-21-72

MISSISSIPPI BOARD OF WATER COMMISSIONERS
416 North State Street
Jackson, Mississippi 39201

CODED

WATER WELL DRILLERS LOG

4-21-1972 date well completed
Herndon-Homan Well & Supply, Inc. MONROE county well located
firm name Box 42
SHANNOK, MISSISSIPPI 38889

LANDOWNER:

Henry Gelopie
At 3 Aberdeen Miss.
(mailing address)

description of formations encountered

Surface sand & clay 0 16
Blue clay 16 260
Sand 260 400
Siltstone 400

from to

WELL LOCATION:

sec 29 T 13 N R 6 E S W
1 1/2 miles NE of Ruyt
(distance) (direction) (nearest town)

WELL PURPOSE:

home
(home, irrigation, municipal, industrial)

WELL COMPLETION DATA:

- (1) diameter (inches) 5"
- (2) total depth (feet) 400'
- (3) static water level (feet) 15' below top of ground.
- (4) casing steel, 20' 7" (material) (depth)
5" (size) if telescope see back.
- (5) screen NO (length) (depth to top)
(size) (material)
- (6) pump 1/2 (HP) 5 (yield gpm)
electric (type power)
- (7) electric log NO (yes or no)
(organization running log)
- (8) how well bottom plugged open

CODED


MAY 12 1972

DRILLERS REMARKS:

MISS. BD. OF WATER COMM.

If well telescopes please sketch and show depths.

GROUND LEVEL

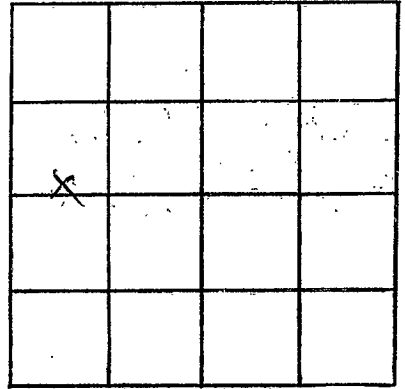

SECTION 29

Please indicate well location X.

ADDITIONAL INFORMATION

If more than one screen,
show locations of each on sketch.