

MONROE
F 42
6-24-72

MISSISSIPPI
BOARD OF WATER COMMISSIONERS
416 North State Street
Jackson, Mississippi 39201
WATER WELL DRILLERS LOG

CODED

6/24 1972 Herman Homan Well & Supply, Inc. MONROE
date/well completed P.O. Box 42 county well located

SHANNON, MISSISSIPPI 38668

LANDOWNER:

(contractors)

Joe H. Crawford

description of formations encountered

from

to

5800 Hwy 51, South Haven
(mailing address) Miss.

Surface sand & clay	0	22
Thin clay	22	210
Sand	210	350
Bottom	350	

WELL LOCATION:

sec. 35 T 13 N R 6 E
4 miles SW of Aberdeen
(distance) (direction) (nearest town)

WELL PURPOSE: Home
(home, irrigation, municipal, industrial)

WELL COMPLETION DATA:

- diameter (inches) 5"
- total depth (feet) 350'
- static water level (feet) 78' below above top of ground.
- casing steel, 25' (material), (depth)
5" (size) if telescope see back.
- screen 20 (length), (depth to top)
(size) (material)
- pump 1/2 (HP), 5 (yield gpm)
electric (type power)
- electric log no (yes or no)
(organization running log)
- how well bottom plugged open

CODED


DRILLERS REMARKS:

III 13 1972

ENCL. OR. 11
LINES QUART

If well telescopes please sketch and show depths.

GROUND LEVEL

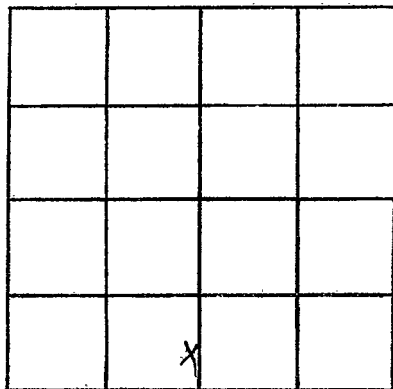

SECTION 30

Please indicate well location X.

ADDITIONAL INFORMATION

If more than one screen,
show locations of each on sketch.