

**MONROE**  
**F44**  
**7-19-72**

MISSISSIPPI  
 BOARD OF WATER COMMISSIONERS  
 416 North State Street  
 Jackson, Mississippi 39201

**WATER WELL DRILLERS LOG**

Herman Homan Well & Supply, Inc.

Monroe  
 county well located

7/19 19 72  
 date well completed

P.O. Box 42  
 firm, MISSISSIPPI 38668  
 SHANNON, MISSISSIPPI 38668

**LANDOWNER:**

**description of formations encountered**

from to

JAMES E. King  
Rt 3 Aberdeen Miss  
 (mailing address)

<u>Surface sand</u>	<u>0</u>	<u>32</u>
<u>clay</u>	<u>32</u>	<u>200</u>
<u>blue clay</u>	<u>200</u>	<u>390</u>
<u>sand</u>	<u>390</u>	
<u>bottom</u>		

**WELL LOCATION:**

sec. 32 T 13 N R. 6 E  
 S W  
1 1/2 miles E of Egypt  
 (distance) (direction) (nearest town)

**WELL PURPOSE:** Home  
 (home, irrigation, municipal, industrial)

**WELL COMPLETION DATA:**

- (1) diameter (inches) 5"
- (2) total depth (feet) 340'
- (3) static water level (feet) 130 below above top of ground.
- (4) casing Steel, 36" 8"  
 (material) (depth)  
5" if telescope see back.  
 (size)
- (5) screen no  
 (length) (depth to top)  
 (size) (material)
- (6) pump 1/2 3  
 (HP) (yield gpm)  
electric  
 (type power)
- (7) electric log no  
 (yes or no)  
 (organization running log)
- (8) how well bottom plugged sped


**AUG 24 1972**

MISS. 22 OF  
 LICENSE #

**DRILLERS REMARKS:**

If well telescopes please sketch and show depths.

GROUND LEVEL

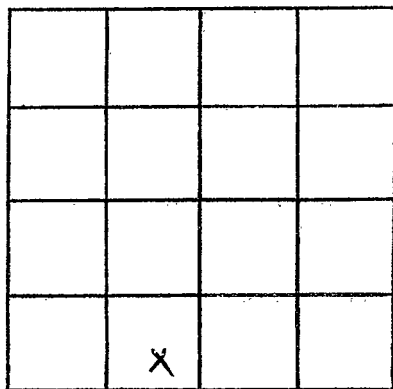

SECTION 72

Please indicate well location X.

ADDITIONAL INFORMATION

If more than one screen, show locations of each on sketch.