

MONROE
F45
7-21-72

CODED

MISSISSIPPI
 BOARD OF WATER COMMISSIONERS
 16 North State Street
 Jackson, Mississippi 39201

WATER WELL DRILLERS LOG

7/21 1972 date well completed
 Herman Homan Well & Supply, Inc. firm name
 Shannon, Mississippi 38868
 Monroe county well located


LANDOWNER:
 Walter Vassar
 P.O. Box 106 Aberdeen Miss.
 (mailing address)

description of formations encountered	from	to
Surface sand	0	33
Blue clay	33	240
Sand	240	380
Bottom	380	

WELL LOCATION:
 sec. 34 T. 13 N R. 6 E S W
 3 miles E of Egypt
 (distance) (direction) (nearest town)

WELL PURPOSE:
 Home
 (home, irrigation, municipal, industrial)

- WELL COMPLETION DATA:**
- (1) diameter (inches) 5"
 - (2) total depth (feet) 380'
 - (3) static water level (feet) 121' below top of ground.
 - (4) casing steel, 32' (material) (depth)
5 if telescope see back. (size)
 - (5) screen no (length) (depth to top)
 (size) (material)
 - (6) pump 1/2 (HP) (yield gpm)
elec drive (type power)
 - (7) electric log no (yes or no)
 (organization running log)
 - (8) how well bottom plugged open

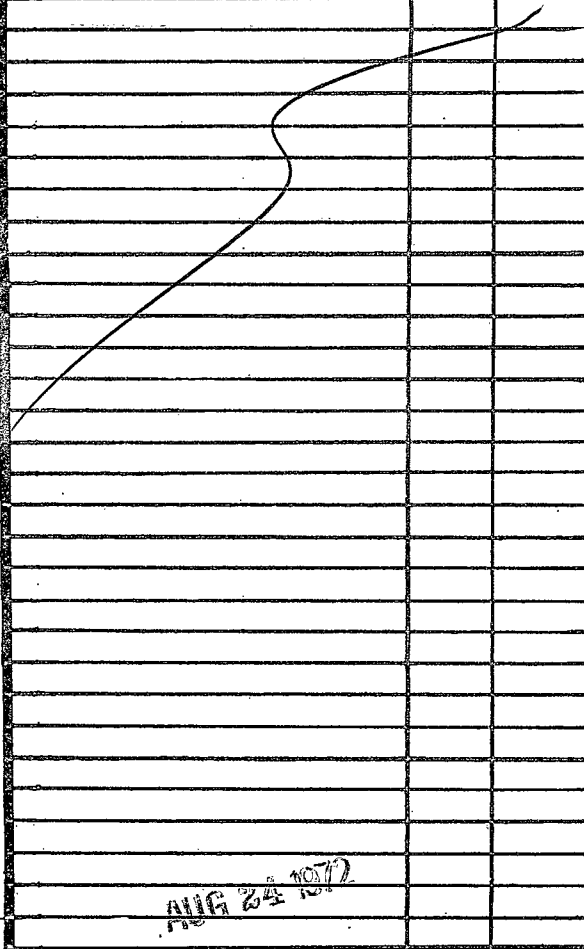


DRILLERS REMARKS:

AUG 24 1972

MISS. BD. OF WATER COMMISSIONERS

If well telescopes please sketch and show depths.

GROUND LEVEL

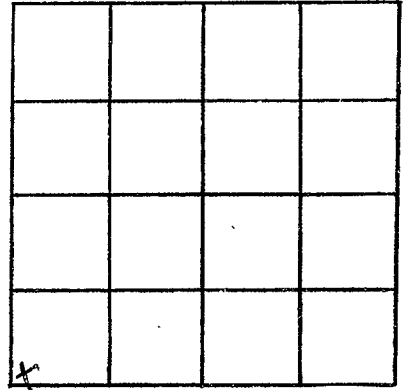

SECTION 34

Please indicate well location X.

ADDITIONAL INFORMATION

If more than one screen, show locations of each on sketch.