

MONROE
F48
12-28-72

MISSISSIPPI
 BOARD OF WATER COMMISSIONERS
 416 North State Street
 Jackson, Mississippi 39201

CODED

WATER WELL DRILLERS LOG

12/28 1972 date well completed
 Herman Homan Well & Supply, Inc.
 P. O. Box 12
 SHANNON, MISSISSIPPI 38650
 MONROE county well located

LANDOWNER: Hawwa's Buddle
James Booth
Rt 1, Okolona, Miss
 (mailing address)

description of fomations encountered	from	to
<u>Surface sand & clay</u>	<u>0</u>	<u>17</u>
<u>Blue clay</u>	<u>17</u>	<u>120</u>
<u>Sand</u>	<u>120</u>	<u>260</u>
<u>Other</u>	<u>260</u>	

WELL LOCATION:
 sec. 12 T. 13 N. R. 6 E
 S W
3/4 miles W of New Wren
 (distance) (direction) (nearest town)

WELL PURPOSE: Home
 (home, irrigation, municipal, industrial)


- WELL COMPLETION DATA:
- (1) diameter (inches) 5
 - (2) total depth (feet) 260
 - (3) static water level (feet) 90 below top of ground.
 - (4) casing steel, 20' (material) (depth)
5 if telescope see back. (size)
 - (5) screen no (length) (depth to top)
 (size) (material)
 - (6) pump 5/2 (HP) 5 (yield gpm)
electric (type power)
 - (7) electric log no (yes or no)
 (organization running log)
 - (8) how well bottom plugged open

DRILLERS REMARKS:

JAN 60 1972
 JAN 60 1972

If well telescopes please sketch and show depths.

GROUND LEVEL

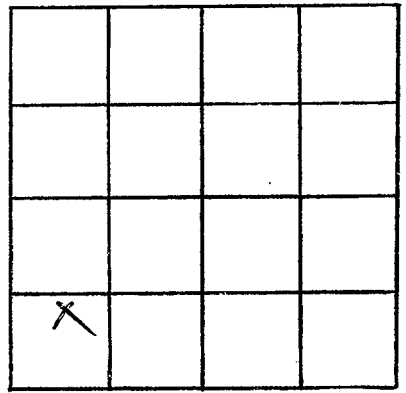

SECTION 12

Please indicate well location X.

ADDITIONAL INFORMATION

Lined area for additional information.

If more than one screen, show locations of each on sketch.