

MONROE

F 50

7-23-73

MISSISSIPPI  
 BOARD OF WATER COMMISSIONERS  
 416 North State Street  
 Jackson, Mississippi 39201

**CODED**

WATER WELL DRILLERS LOG

Herman Homan Well & Supply, Inc.

Monroe

6-25 1973  
date well completed

P.O. Box 42

SHANNON MISSISSIPPI 38468

county well located

LANDOWNER: *contractor*

Hanna Bullock

description of formations encountered

from

to

VASSOU

Surface sand

0 16

1 Okolona, Miss  
(mailing address)

Blue clay

16 18

Sand

18 300

Bottom

300

WELL LOCATION:

sec. 35 T. 53 N. R. 6 E.  
S. W.  
of miles NE of Gibson  
(distance) (direction) (nearest town)

WELL PURPOSE: Home  
(home, irrigation, municipal, industrial)

**CODED**

WELL COMPLETION DATA:

- (1) diameter (inches) 5"
- (2) total depth (feet) 200'
- (3) static water level (feet) 83' below top of ground.
- (4) casing steel, 2 1/2'  
(material) (depth)  
5 1/4" if telescope see back.  
(size)
- (5) screen NO,  
(length) (depth to top)  
(size) (material)
- (6) pump 1/2 5  
(HP) (yield gpm)  
electric  
(type power)
- (7) electric log NO  
(yes or no)  
(organization running log)
- (8) how well bottom plugged open


JUL 18 1973

DRILLERS REMARKS:

MISS. BD. OF  
WATER COM.

If well telescopes please sketch and show depths.

GROUND LEVEL

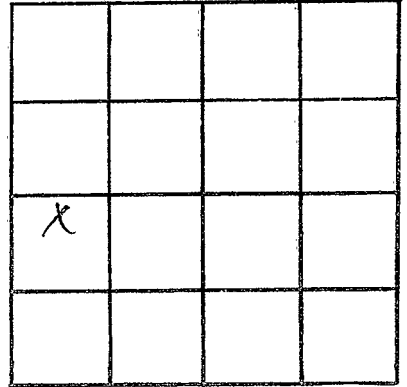

SECTION 35

Please indicate well location X.

ADDITIONAL INFORMATION

If more than one screen,  
show locations of each on sketch.