

MONROE  
F51  
8-23-73

MISSISSIPPI  
BOARD OF WATER COMMISSIONERS  
416 North State Street  
Jackson, Mississippi 39201

CODED

WATER WELL DRILLERS LOG

8/23 1973 Herman Homan Well & Supply, Inc. Monroe  
date well completed 1973 county well located

SHANNON, MISSISSIPPI 38608

LANDOWNER: L.C. Cook Contract  
Eddie James  
Rt 1, Okolona, Miss.  
(mailing address)

description of formations encountered	depth	
	from	to
surface sand	0	16
clay	16	220
blue clay	220	360
sand	360	
bottom		

WELL LOCATION:  
sec. 6 T. 13 N R. 6 E  
5 1/2 miles W of New Wren  
(distance) (direction) (nearest town)

WELL PURPOSE: Home  
(home, irrigation, municipal, industrial)

- WELL COMPLETION DATA:
- (1) diameter (inches) 5"
  - (2) total depth (feet) 360'
  - (3) static water level (feet) 128' below top of ground.
  - (4) casing steel 23' (material) (depth)  
5" (size) if telescope see back.
  - (5) screen NO (length) (depth to top)  
(size) (material)
  - (6) pump 1/2 (HP) 5 (yield gpm)  
electric (type power)
  - (7) electric log NO (yes or no)  
(organization running log)
  - (8) how well bottom plugged open


CODED

DRILLERS REMARKS:

SEP 4 1973

If well telescopes please sketch and show depths.

GROUND LEVEL

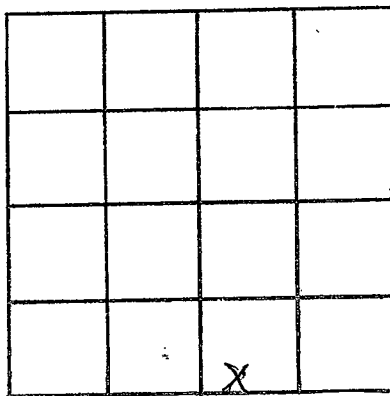

SECTION 6

Please indicate well location X.

ADDITIONAL INFORMATION

If more than one screen, show locations of each on sketch.