

MONROE

F52

8-24-73

MISSISSIPPI
 BOARD OF WATER COMMISSIONERS
 416 North State Street
 Jackson, Mississippi 39201

WATER WELL DRILLERS LOG

CODED

Herman Homan Well & Supply, Inc.

Monroe

8/24 1973
date well completed

P.O. Box 42
firm name

county well located

SHANNON, MISSISSIPPI 38868

LANDOWNER:

Anna Biddle

description of formations encountered

from

to

Celest Ford

Surface sand & clay

0

25

Rt 3, Aberdeen, Miss
(mailing address)

Blue clay

25

160

Sand

160

300

Bottom

300

WELL LOCATION:

sec 21 T 13 N R 6 E

4 miles (distance)

S W

(direction)

of New Wrea (nearest town)

WELL PURPOSE:

Home (home, irrigation, municipal, industrial)

WELL COMPLETION DATA:

(1) diameter (inches) 5"

(2) total depth (feet) 300'

(3) static water level (feet) 114' below top of ground

(4) casing steep 42.5" (material) (depth)

if telescope see back. (size)

(5) screen 20 (length) (depth to top)

(size) (material)

(6) pump 1/2 (HP) 5 (yield gpm)

elect (type power)

(7) electric log NO (yes or no)

(organization running log)

(8) how well bottom plugged open


CODED

DRILLERS REMARKS:

SEP 19 1973

If well telescopes please sketch and show depths.

GROUND LEVEL

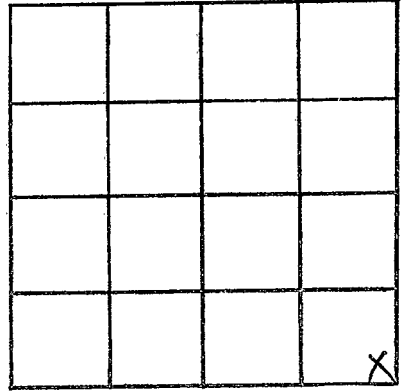

SECTION 21

Please indicate well location X.

ADDITIONAL INFORMATION

If more than one screen, show locations of each on sketch.