

MONROE

F 5A

10-23-73

MISSISSIPPI BOARD OF WATER COMMISSIONERS
416 North State Street
Jackson, Mississippi 39201

CODED

WATER WELL DRILLERS LOG

Herman Homan Well & Supply, Inc.

P. O. Box 42

SHANNON, MISSISSIPPI 38668

Monroe

10-23-73
date well completed

Monroe
county well located

LANDOWNER:

JAMES Hill

Rt 1, Ofalona, Miss.
(mailing address)

description of formations encountered

description of formations encountered	from	to
Surface sand & clay	0	16
Blue clay	16	190
Sand	190	260
Bottom	260	

WELL LOCATION:

sec. 2 T. 3 N. R. 6 E.
S. W. 1 miles SW of Shannon
(distance) (direction) (nearest town)

WELL PURPOSE: Home
(home, irrigation, municipal, industrial)

WELL COMPLETION DATA:

- (1) diameter (inches) 8 1/2
- (2) total depth (feet) 260'
- (3) static water level (feet) 108' below top of ground.
- (4) casing Steel, 21' (material), (depth)
50' if telescope see back. (size)
- (5) screen ND (length), (depth to top)
(size) (material)
- (6) pump 1/2 (HP), 5 (yield gpm)
electric (type power)
- (7) electric log ND (yes or no)
(organization running log)
- (8) how well bottom plugged open


CODED

DRILLERS REMARKS:

NOV 26 1973
MISSISSIPPI
WATER COMMISSIONERS

If well telescopes please sketch and show depths.

GROUND LEVEL

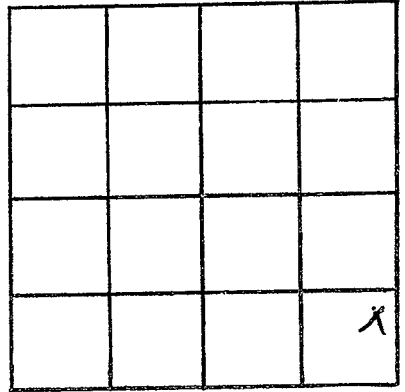

SECTION 2

Please indicate well location X.

ADDITIONAL INFORMATION

If more than one screen, show locations of each on sketch.