

MONROE
F 55
11-20-73

MISSISSIPPI
 BOARD OF WATER COMMISSIONERS
 416 North State Street
 Jackson, Mississippi 39201

CODED

WATER WELL DRILLERS LOG

Herman Homan Well & Supply, Inc.

11/20 1973
 date well completed

Monroe
 county well located

P.O. Box 42
 SHANNON, MISSISSIPPI 38668

LANDOWNER:

Leola Toupe
 Rt 3 Aberdeen Miss
 (mailing address)

description of formations encountered

from to

Surface sand	0	16
clay		
Blue clay	16	160
sand	160	507
Bit. clay	300	

WELL LOCATION:

sec. 34 T. 13 N R. 6 E
 3 miles NE of Gibson
 (distance) (direction) (nearest town)

WELL PURPOSE:

Home
 (home, irrigation, municipal, industrial)

WELL COMPLETION DATA:

- diameter (inches) 5"
- total depth (feet) 300'
- static water level (feet) 160' below top of ground.
- casing Steel 21' (material) (depth)
 5" if telescope see back. (size)
- screen ND (length) (depth to top)
 (size) (material)
- pump 1/2 (HP) 5 (yield gpm)
 electric (type power)
- electric log ND (yes or no)

(organization running log)

(8) how well bottom plugged Open


DRILLERS REMARKS:

CODED

JAN 2

If well telescopes please sketch and show depths.

GROUND LEVEL

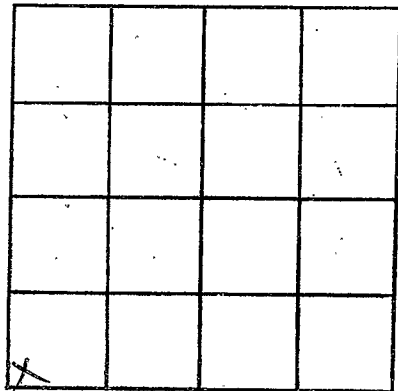

SECTION 34

Please indicate well location X.

ADDITIONAL INFORMATION

If more than one screen, show locations of each on sketch.