

MONROE
F56
5-10-74

MISSISSIPPI
BOARD OF WATER COMMISSIONERS
416 North State Street
Jackson, Mississippi 39201
CODED
WATER WELL DRILLERS LOG

5/10 1974 Herman Homan Well & Supply, Inc. Monroe
date well completed 42 county well located

LANDOWNER:

Car. Thomas
Rt 3 Aberdeen Miss
(mailing address)

description of formations encountered

from to

Surface clay 0 16
Blue clay 16 160
Sand 160 300
Bottom 300

WELL LOCATION:

sec 35 T 13 N R 6 E
S
4 miles NE of Aberdeen
(distance) (direction) (nearest town)

WELL PURPOSE: Home
(home, irrigation, municipal, industrial)

WELL COMPLETION DATA:

- (1) diameter (inches) 5 1/2
- (2) total depth (feet) 300
- (3) static water level (feet) 70 below top of ground.
- (4) casing (material) steel (depth) 200 ft
5 1/2" if telescope see back.
(size)
- (5) screen ND (length) (depth to top)
(size) (material)
- (6) pump 1/2 HP (yield gpm) 5
(type power) electric
- (7) electric log yes or no
- (organization running log)
- (8) how well bottom plugged open


CODED

DRILLERS REMARKS:

MAY 17 1974
MISS. Bd. OF WATER COMM

If well telescopes please sketch and show depths.

GROUND LEVEL

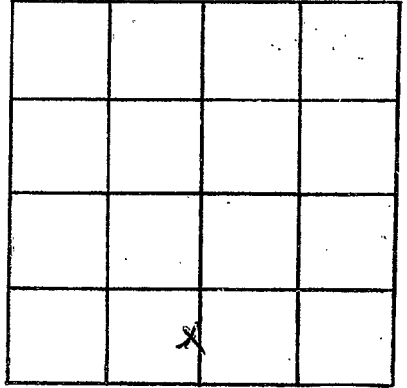

SECTION 35

Please indicate well location X.

ADDITIONAL INFORMATION

If more than one screen,
show locations of each on sketch.