

**MONROE**  
**F 57**  
**C-24-74**

**MISSISSIPPI**  
**BOARD OF WATER COMMISSIONERS**  
 416 North State Street  
 Jackson, Mississippi 39201

**CODED**

**WATER WELL DRILLERS LOG**

Herman Homan Well & Supply, Inc.  
 P. O. Box 42  
 firm name

*Monroe*  
*Shickman*

*8/24*  
 date well completed

*1974*

**SHANNON, MISSISSIPPI 38868**

county well located

**LANDOWNER:**  
*Clay Johnson*  
*Ret Okolona Miss.*  
 (mailing address)

description of formations encountered	from	to
<i>Surface sand &amp; clay</i>	<i>0</i>	<i>26</i>
<i>Blue clay</i>	<i>26</i>	<i>220</i>
<i>Sand</i>	<i>220</i>	<i>360</i>
<i>Bottom</i>	<i>360</i>	


**WELL LOCATION:**  
 sec. *6* T. *13* N. R. *6* E.  
 S. W.  
*5/4* miles *W* of *Wren*  
 (distance) (direction) (nearest town)

**WELL PURPOSE:** *Water*  
 (home, irrigation, municipal, industrial)

- WELL COMPLETION DATA:**
- (1) diameter (inches) *5 1/4*
  - (2) total depth (feet) *360'*
  - (3) static water level (feet) *97'* below above top of ground.
  - (4) casing *Steel*, *42 1/2"* (material) (depth)  
*5 1/4* (size) If telescope see back.
  - (5) screen *NO* (length) (depth to top)  
 (size) (material)
  - (6) pump *1/2* *5* (HP) (yield gpm)  
*Electric* (type power)
  - (7) electric log *NO* (yes or no)  
 (organization running log)
  - (8) how well bottom plugged *Open*

**DRILLERS REMARKS:**


**CODED**

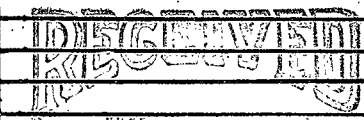

*8-1-1974*

If well telescopes please sketch and show depths.

GROUND LEVEL

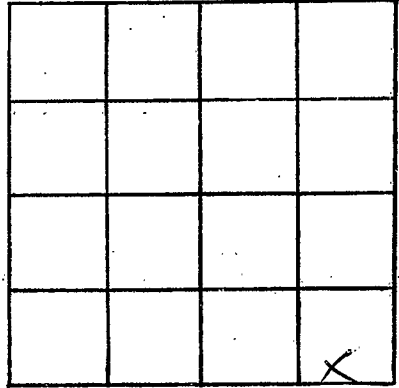

SECTION 6

Please indicate well location X.

ADDITIONAL INFORMATION

If more than one screen, show locations of each on sketch.