

MONROE
F 58
7-3-74

MISSISSIPPI
BOARD OF WATER COMMISSIONERS
416 North State Street
Jackson, Mississippi 39201

CODED

WATER WELL DRILLERS LOG

7-3 19 74 Herman Homan Well & Supply, Inc. Monroe
date well completed firm, r.o. box 42 county well located

SHANNON, MISSISSIPPI 39068

LANDOWNER:	description of formations encountered	from	to
Dave McIntosh	surface sand	0	16
AP1 Oxford, Miss. (mailing address)	blue clay	16	180
	Sand	180	300
	Bitum	300	

WELL LOCATION:
sec. 1 T 13 N R. 6 E
S W
1 miles NW of Wren
(distance) (direction) (nearest town)

WELL PURPOSE: Home
(home, irrigation, municipal, industrial)

- WELL COMPLETION DATA:
- (1) diameter (inches) 4"
 - (2) total depth (feet) 300'
 - (3) static water level (feet) 125' below top of ground above
 - (4) casing Steel 25' 4"
(material) (depth)
4" if telescope see back.
(size)
 - (5) screen NO
(length) (depth to top)
(size) (material)
 - (6) pump HP
(HP) (yield gpm)
(type power)
 - (7) electric log NO
(yes or no)
(organization running log)
 - (8) how well bottom plugged open

DRILLERS REMARKS:

CODED


CONTAINING
BY

AUG - 8 1974

WATER COMMISSIONERS

If well telescopes please sketch and show depths.

GROUND LEVEL

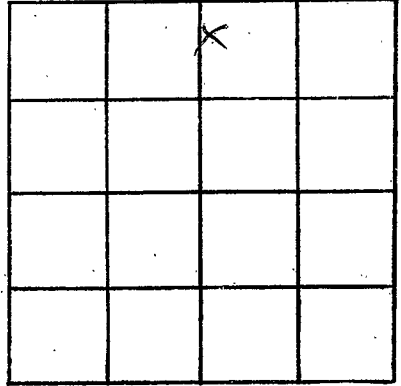

SECTION 1

Please indicate well location X.

ADDITIONAL INFORMATION

If more than one screen, show locations of each on sketch.