

MONROE
F 59
7-12-74

MISSISSIPPI
 BOARD OF WATER COMMISSIONERS
 416 North State Street
 Jackson, Mississippi 39201

CODED

WATER WELL DRILLERS LOG

7-12 date well completed
 1974 Herman Homan Well & Supply, Inc. P.O. Box 42 firm name
 SHANNON MISSISSIPPI 38468
 Monroe county well located

LANDOWNER:
 Aron McAlister
 Rt 3 Aberdeen, Miss
 (mailing address)

description of formations encountered	from	to
Surface sand & clay	0	35
Blue clay	35	220
Sand	220	360
Bottom	360	

WELL LOCATION:
 sec 32 T 13 N R 6 E
 S W
 1/2 miles N of Gibson
 (distance) (direction) (nearest town)

WELL PURPOSE: Home
 (home, irrigation, municipal, industrial)

- WELL COMPLETION DATA:**
- (1) diameter (inches) 5"
 - (2) total depth (feet) 360'
 - (3) static water level (feet) 124' below top of ground.
 - (4) casing Steel 42' (material) (depth)
 5' If telescope see back. (size)
 - (5) screen no (length) (depth to top)
 (size) (material)
 - (6) pump 1/2 (HP) 5 (yield gpm)
 electric (type power)
 - (7) electric log no (yes or no)
 - (organization running log)
 - (8) how well bottom plugged open

DRILLERS REMARKS:


CODED

RECEIVED
 AUG - 8 1974

MISS. BD. OF WATER COMMISSIONERS

If well telescopes, please sketch and show depths.

GROUND LEVEL

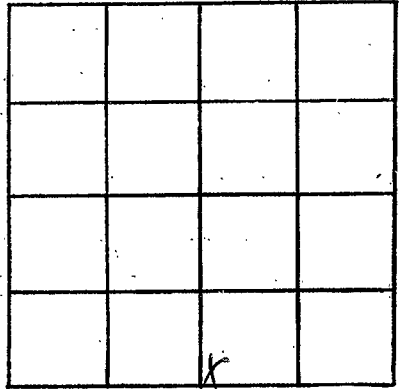

SECTION 32

Please indicate well location X.

ADDITIONAL INFORMATION

If more than one screen, show locations of each on sketch.