

MONROE

F60

7-29-74

MISSISSIPPI
 BOARD OF WATER COMMISSIONERS
 416 North State Street
 Jackson, Mississippi 39201

CODED

WATER WELL DRILLERS LOG

Herman Homan Well & Supply, Inc.

Monroe

7-29 1974 date well completed

SHANNON, MISSISSIPPI 39160

county well located

LANDOWNER:

James Playbock
 Rt 1, Okolona, Miss.
 (mailing address)

description of formations encountered

from to

Surface sand 0 22
 Blue clay 22 160
 Sand 160 300
 Bottom 300

WELL LOCATION:

sec. 2 T 13 N R 6 E
 S W
 1 miles NW of Wood
 (distance) (direction) (nearest town)

WELL PURPOSE: Home
 (home, irrigation, municipal, industrial)

WELL COMPLETION DATA:

- (1) diameter (inches) 4 1/2
- (2) total depth (feet) 300
- (3) static water level (feet) 124 below top of ground.
- (4) casing steel 2 1/2" (material) (depth)
- 4" (size) if telescope see back.
- (5) screen no (length) (depth to top)
- (size) (material)
- (6) pump 1/2 (HP) 5 (yield gpm)
- electric (type power)
- (7) electric log no (yes or no)

(organization running log)

(8) how well bottom plugged open

DRILLERS REMARKS:


CODED

REGISTERED

AUG - 8 1974

If well telescopes please sketch and show depths.

GROUND LEVEL

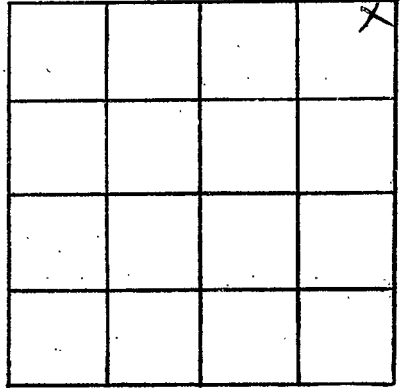

SECTION 2

Please indicate well location X.

ADDITIONAL INFORMATION

Lined area for additional information.

If more than one screen, show locations of each on sketch.