

MONROE
 F61
 12-27-74

MISSISSIPPI
 BOARD OF WATER COMMISSIONERS
 416 North State Street
 Jackson, Mississippi 39201

WATER WELL DRILLERS LOG

12/27 1974 date well completed
 Herman Homan Well & Supply, Inc. firm name
 P.O. Box 42 SWANNON MISSISSIPPI 38660
 Monroe county well located

LANDOWNER:
 Jerry Johnson
 Rt 3, Aberdeen, Miss.
 (mailing address)

description of formations encountered	from	to
Surface sand & clay	0	18
Blue clay	18	60
Sand	60	320
Bottom	320	PAO


WELL LOCATION:
 sec. 35 T. 13 N. R. 6 E. (13L)
 S W
 4 miles NW of Aberdeen
 (distance) (direction) (nearest town)

WELL PURPOSE: Home
 (home, irrigation, municipal, industrial)

- WELL COMPLETION DATA:
- (1) diameter (inches) 4 1/2
 - (2) total depth (feet) 300'
 - (3) static water level (feet) 69' below top of ground.
 - (4) casing steel, 21' (material) (depth)
 4 1/2" (size) if telescope see back.
 - (5) screen 20" (length) (depth to top)
 (size) (material)
 - (6) pump 1/2 HP, 5 (yield gpm)
 electric (type power)
 - (7) electric log NO (yes or no)
 (organization running log)
 - (8) how well bottom plugged open

DRILLERS REMARKS:

CODED

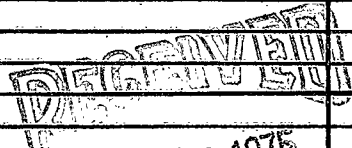


JAN 16 1975

OF WATER

If well telescopes please sketch and show depths.

GROUND LEVEL

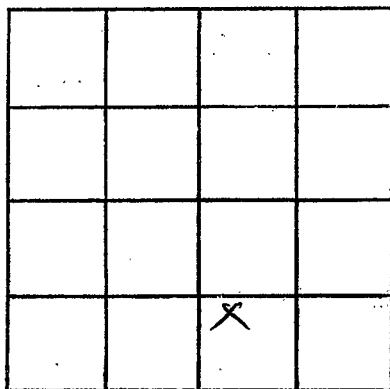

SECTION 35

Please indicate well location X.

ADDITIONAL INFORMATION

If more than one screen, show locations of each on sketch.