

Monroe  
F 62  
6-16-75

MISSISSIPPI  
 BOARD OF WATER COMMISSIONERS  
 416 North State Street  
 Jackson, Mississippi 39201

CODED

WATER WELL DRILLERS LOG

6/16 1975 Herman Homan Well & Supply, Inc.  
 date well completed firm name  
 P. O. Box 12  
 SHANNON, MISSISSIPPI 38868 county well located Monroe

LANDOWNER:	description of formations encountered	from	to
<u>Leaning Rice</u>	<u>surface clay</u>	<u>0</u>	<u>34</u>
<u> Rt 3, Aberdeen, Miss</u>	<u>shale clay</u>	<u>34</u>	<u>260</u>
(mailing address)	<u>sand</u>	<u>260</u>	<u>400</u>
	<u>Other</u>	<u>400</u>	
WELL LOCATION:			
sec. <u>32</u> T. <u>13</u> N. R. <u>6</u> E. <sup>13L</sup>			
<u>4</u> miles <u>N</u> of <u>Gibson</u>			
(distance) (direction) (nearest town)			
WELL PURPOSE: <u>Home</u>			
(home, irrigation, municipal, industrial)			
WELL COMPLETION DATA:			
(1) diameter (inches) <u>4"</u>			
(2) total depth (feet) <u>468'</u>			
(3) static water level (feet) <u>135'</u> below top of ground.			
(4) casing <u>Steel</u> , <u>57'3"</u>			
(material) (depth)			
<u>4"</u> if telescope see back.			
(size)			
(5) screen <u>NO</u>			
(length) (depth to top)			
(size) (material)			
(6) pump <u>1/2</u> <u>5</u>			
(HP) (yield gpm)			
<u>elect</u>			
(type power)			
(7) electric log <u>NO</u>			
(yes or no)			
(organization running log)			
(8) how well bottom plugged <u>open</u>			
DRILLERS REMARKS:			


CODED

MISS. BD. OF WATER COMMISSIONERS  
 JUL 11 1975

MISS. BD. OF WATER COMMISSIONERS

If well telescopes please sketch and show depths.

GROUND LEVEL

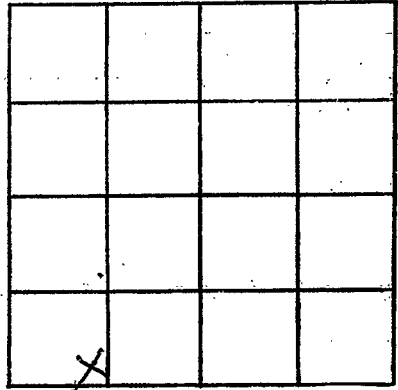

SECTION 32

Please indicate well location X.

ADDITIONAL INFORMATION

If more than one screen, show locations of each on sketch.