

Monroe
 E 63
 8-15-75

MISSISSIPPI
 BOARD OF WATER COMMISSIONERS
 416 North State Street
 Jackson, Mississippi 39201

CODED

WATER WELL DRILLERS LOG

8/15 19 75 Herman Homan Well & Supply, Inc. Monroe
 date well completed firm, Box 42 county well located

SHANNON, MISSISSIPPI 38686

LANDOWNER:	description of formations encountered	from	to
Ernest Collins	Surface clay	0	35
Dr. J. A. Jordan, M.D. (mailing address)	Blue clay	35	200
	Sand	200	320
	Bottom	320	

WELL LOCATION:
 sec. 20 T 13 N R 6 E 13L
 4 1/2 miles S W of New Wood
 (distance) (direction) (nearest town)

WELL PURPOSE: Home
 (home, irrigation, municipal, industrial)

- WELL COMPLETION DATA:
- (1) diameter (inches) 4"
 - (2) total depth (feet) 325'
 - (3) static water level (feet) 130' below top of ground
 - (4) casing steel, 9 1/2"
 (material) (depth)
4" If telescope see back.
 (size)
 - (5) screen no
 (length) (depth to top)
 (size) (material)
 - (6) pump 4 1/2 5
 (HP) (yield gpm)
electric
 (type power)
 - (7) electric log no
 (yes or no)
 - (organization running log)
 - (8) how well bottom plugged no


CODED

RECEIVED
 AUG 18 1975

DRILLERS REMARKS:

If well telescopes please sketch and show depths.

GROUND LEVEL

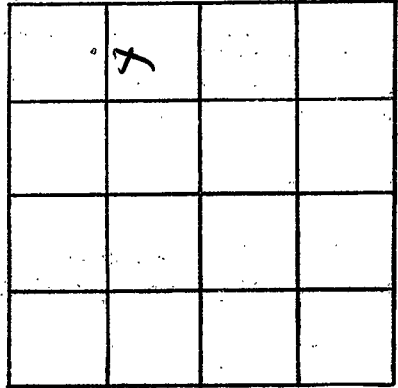

SECTION 20

Please indicate well location X.

ADDITIONAL INFORMATION

If more than one screen,
show locations of each on sketch.