

Monroe
F 64
7-10-75

MISSISSIPPI
BOARD OF WATER COMMISSIONERS
416 North State Street
Jackson, Mississippi 39201


CODED

WATER WELL DRILLERS LOG

7/10 1975 Herman Homan Well & Supply, Inc.
date well completed P. O. Box 42
SHANNON, MISSISSIPPI 38868 Monroe county well located


LANDOWNER:	description of formations encountered	from	to
EVAN MAE Johnson Abz Aberdeen, Miss (mailing address)	Surface clay Blue clay Sand Bottom	0 28 160 300	28 160 300
<p>WELL LOCATION:</p> <p>sec 35 T 13 N R 6 E 13L S 4 miles NW of Aberdeen (distance) (direction) (nearest town)</p>			
<p>WELL PURPOSE: Home (home, irrigation, municipal, industrial)</p>			
<p>WELL COMPLETION DATA:</p>			
<p>(1) diameter (inches) 4 1/2</p>			
<p>(2) total depth (feet) 300'</p>			
<p>(3) static water level (feet) 124' below top of ground.</p>			
<p>(4) casing Steel, 32', (material) (depth) 4 1/2" If telescope see back. (size)</p>			
<p>(5) screen NO (length) (depth to top) (size) (material)</p>			
<p>(6) pump 1/2 HP 5 (yield gpm) electric (type power)</p>			
<p>(7) electric log NO (yes or no)</p>			
<p>(organization running log)</p>			
<p>(8) how well bottom plugged open</p>			
<p>DRILLERS REMARKS:</p>			

CODED

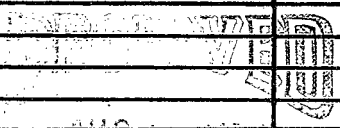

If well telescopes please sketch and show depths.

GROUND LEVEL

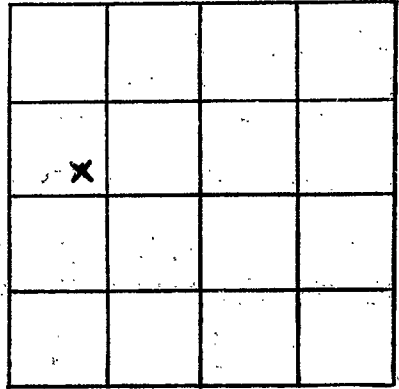

SECTION 25

Please indicate well location X.

ADDITIONAL INFORMATION

If more than one screen, show locations of each on sketch.