

MONROE
F 68
CODED

MISSISSIPPI
BOARD OF WATER COMMISSIONERS
416 North State Street
Jackson, Mississippi 39201

WATER WELL DRILLERS LOG

date well completed JUNE 1981 firm name LEEPER Drilling county well located MONROE

LANDOWNER: White Rock Baptist church
RT 1 ABERDEEN MS.
(mailing address)

description of fomations encountered	from	to
<u>TOP clay</u>	<u>0</u>	<u>20</u>
<u>Blue clay</u>	<u>20</u>	<u>25</u>
<u>CHALK</u>	<u>25</u>	<u>320</u>
<u>SAND</u>	<u>320</u>	<u>400</u>

WELL LOCATION:
sec. 22 T 13 N R. 6 E
EGYPT COMMUNITY
(distance) 1 miles (direction) S of (nearest town) W

WELL PURPOSE: Home
(home, irrigation, municipal, industrial)

- WELL COMPLETION DATA:
- diameter (inches) 4 1/2"
 - total depth (feet) 400
 - static water level (feet) 90 below
top of ground above
 - casing PVC, 40'
(material) (depth)
4 1/2"
(size) if telescope see back.
 - screen NONE
(length) (depth to top)
(size) (material)
 - pump 3/4 10
(HP) (yield gpm)
elec
(type power)
 - electric log NO
(yes or no)
(organization running log)
 - how well bottom plugged open

RECEIVED


AUG 04 1981

Department of Natural Resources
Bureau of Land & Water

DRILLERS REMARKS:

If well telescopes please sketch and show depths.

GROUND LEVEL

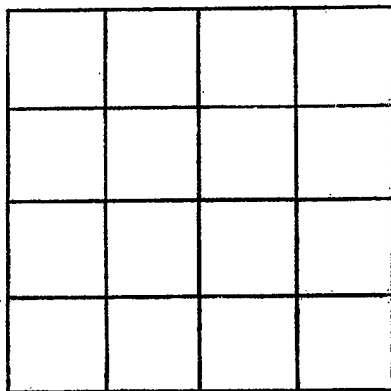

SECTION _____

Please indicate well location X.

ADDITIONAL INFORMATION

If more than one screen, show locations of each on sketch.