

MISSISSIPPI DEPARTMENT OF NATURAL RESOURCES

Bureau of Land and Water Resources

Southport Mall

P.O. Box 10631

Jackson, Mississippi 39209

WATER WELL DRILLERS LOG

MONROE  
F-69  
12-14-91

Coded

MONROE  
CHICKASAW

12-14-91  
date well completed

T.M. PARKS DRILLING & SALES  
firm name

county well located

LANDOWNER: EAST CHICKASAW  
WATER ASSN.  
P.O. Box 87  
OKOLONA, MS 38860  
(mailing address)

description of formations encountered

from

to

WELL LOCATION:  
sec. 6 T 13 N R 6 E  
COUNTYLINE Rd. OKOLONA  
(distance) (direction) (nearest town)

TOP SOIL	0	30
CLAYS, CHALKS	30	440
SHALE W/ FINE SAND	440	470
FINE SAND	470	490
SANDY SHALE W/CLAY	490	520
CLAY, SHALE, LUMP SAND	520	590
GOOD SAND W/ SHALE	590	620

WELL PURPOSE: MUNICIPAL  
(home, irrigation, municipal, industrial)

WELL COMPLETION DATA:

- (1) diameter (inches) 13 3/4"
- (2) total depth (feet) 480'
- (3) static water level (feet) 136' below top of ground.
- (4) casing STEEL 392' (material), (depth)
- (size) if telescope see back.
- (5) screen 60' 400' (length), (depth to top)  
6" STEEL (size), (material)
- (6) pump 40 250 (HP), (yield gpm)  
3 PHASE (type power)
- (7) electric log YES (yes or no)  
MGS (organization running log)
- (8) how well bottom plugged BVP




JUN 05 1991

Dept. of Environmental Quality  
Bureau of Land & Water Resources

DRILLERS REMARKS:

If well telescopes please sketch and show depths.

GROUND LEVEL

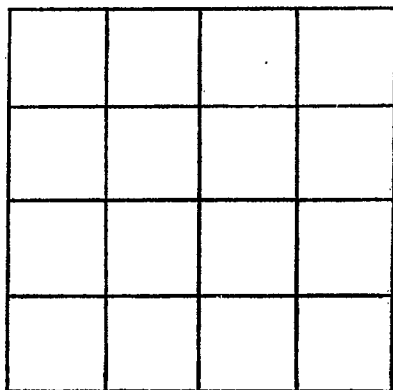

SECTION \_\_\_\_\_

Please indicate well location X.

ADDITIONAL INFORMATION

If more than one screen,  
show locations of each on sketch.