

MONROE

MISSISSIPPI BOARD OF WATER COMMISSIONERS

F

F301

1-3-62

WATER WELL DRILLERS LOG  
HERNDON WELL & SUPPLY CO.

Monroe

Date Jan 3, 1962, Driller: SHANNON, MISSISSIPPI County  
(Name)

P. O. BOX 42

~~Shannon~~


(1) Owner of Land:	Description & Color of Materials Sand, Clay, Red Clay, Shell, etc.	Thick- ness Feet	Depth Feet
Garfield Wise (Name) Okolona, Miss. (Address)	Surface sand & clay		0
(2) Location: <u>1/4</u> , <u>1/4</u> , Sec <u>16</u> T. <u>135</u> R. <u>6E</u> <u>3</u> miles <u>South</u> , of <u>Okolona</u> (distance) (direction) (Nearest Town)	Blue sand		17
(3) Topography: <u>Flat</u> (Hilly) (Flat) (Level)	Sand	260	
(4) Purpose of Well: <u>Domestic</u> (Domestic Irrigation Municipal, Industrial, Other)	Bottom	300	

Information upon completion of well:

- (1) Diameter 4 inches.
- (2) Total Depth 300 feet.
- (3) Water Level 90 feet below top of ground.
- (4) Cased to 19'7", Size 4"
- (5) Screen: Size     , Length
- (6) Were any formations sealed against pollution?  
 yes,  no.

If YES depth of formation 17'  
Why Surface & sand

Drillers Remarks:

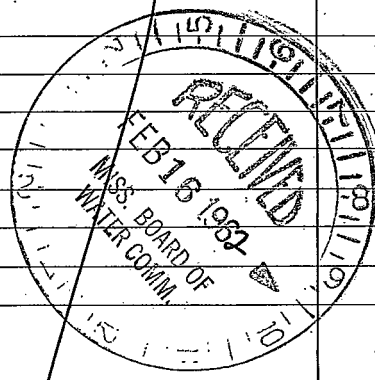

(Use Back Side)

Well No.

[The page contains extremely faint and illegible text, likely bleed-through from the reverse side of the document. No specific words or phrases can be discerned.]