

MONROE

MISSISSIPPI BOARD OF WATER COMMISSIONERS

F 7000

3-17-62

WATER WELL DRILLERS LOG

HERNDON WELL & SUPPLY CO.

Date: March 17, 1962, Driller: P. O. BOX 42 County Monroe

SHANNON (Name) MISSISSIPPI

75-8

(1) Owner of Land:	Description & Color of Materials Sand, Clay, Red Clay, Shell, etc.	Thick- ness Feet	Depth Feet
<u>Clude Reddick</u> (Name) <u>Okolona, Miss.</u> (Address)	<u>Soil of clay</u>		0
(2) Location: <u>1/4</u> , <u>1/4</u> , Sec. <u>8 1356 E</u> <u>R 6 E</u>	<u>Blue sand</u>		25
<u>3</u> miles <u>SE</u> , of <u>Okolona</u> (distance) (direction) (Nearest Town)	<u>Sand</u>		270
(3) Topography: <u>Flat</u> (Hilly) (Flat) (Level)	<u>Bottom</u>		340
(4) Purpose of Well: <u>Domestic</u> (Domestic, Irrigation, Municipal, Industrial, Other)			


Information upon completion of well:

- (1) Diameter 4 inches.
- (2) Total Depth 340 feet.
- (3) Water Level 50 feet below top of ground.
- (4) Cased to 29' 3", Size 4"
- (5) Screen: Size —, Length —
- (6) Were any formations sealed against pollution?  
yes, no.

If YES depth of formation 25 ft.

Why Super sand

Drillers Remarks:

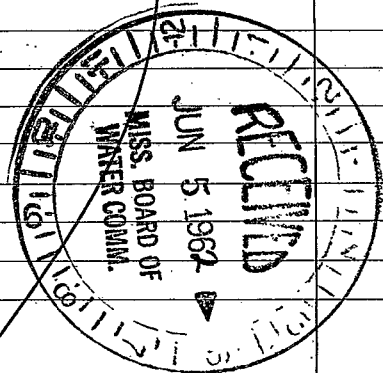

(Use Back Side)

Well No.

