

MONROE

F 7002

11-64

MISSISSIPPI
 BOARD OF WATER COMMISSIONERS
 416 North State Street
 Jackson, Mississippi 39201

WATER WELL DRILLERS LOG

Herndon-Homan Well & Supply, Inc. *Monroe*

Nov. 17 1966
date well completed

P. O. Box 42

~~Herndon-Homan Well & Supply, Inc.~~ *Monroe*
county well located

LANDOWNER: *Lilly Mae Hagner*

Associated Builders (cont)

Tupelo, Miss.
(mailing address)

WELL LOCATION:

sec. 6 T. 13 N. R. 6 E.
S. W.
4 miles SE of St. Louis
(distance) (direction) (nearest town)

WELL PURPOSE: Home
(home, irrigation, municipal, industrial)

WELL COMPLETION DATA:

- (1) diameter (inches) 4"
- (2) total depth (feet) 360'
- (3) static water level (feet) 105 Below above top of ground.

(4) casing Steel, 3 7/8"
(material) (depth)

_____ If telescope see back.
(size)

(5) screen None
(length) (depth to top)

_____ (size) _____ (material)

(6) pump 3/4 5
(HP) (yield gpm)

Electric
(type power)

(7) electric log no
(yes or no)

_____ (organization running log)

(8) how well bottom plugged Open


DRILLERS REMARKS:

description of formations encountered	from	to
<i>surface sand & clay</i>	<i>0</i>	<i>35</i>
<i>bleak clay</i>	<i>35</i>	<i>240</i>
<i>sand</i>	<i>240</i>	<i>360</i>
<i>bottom</i>	<i>360</i>	



If well telescopes please
sketch and show depths.

GROUND LEVEL

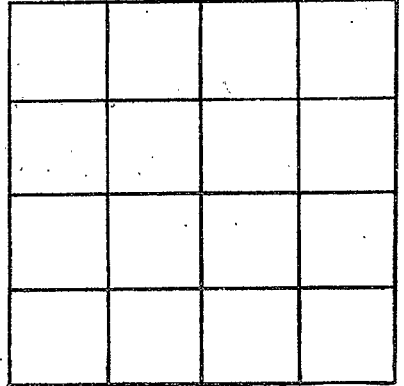

SECTION _____

Please indicate well location X.

ADDITIONAL INFORMATION

If more than one screen,
show locations of each on sketch.