

MONROE
F 2003
11-66

MISSISSIPPI
BOARD OF WATER COMMISSIONERS
416 North State Street
Jackson, Mississippi 39201

WATER WELL DRILLERS LOG

~~Herndon-Homan Well & Supply, Inc.~~ *Monroe*
P. O. Box 42
~~2205 N. 10th St. Jackson, Miss. 39204~~
date well completed *Nov. 17 1966* county well located *Monroe*


LANDOWNER: *James F. Smith*
Associated Builders (Co.)
Capela, Miss.
(mailing address)

description of formations encountered	from	to
<i>surface sand</i>	<i>0</i>	<i>20</i>
<i>to clay</i>	<i>20</i>	<i>240</i>
<i>blue clay</i>	<i>240</i>	<i>360</i>
<i>sand</i>	<i>360</i>	
<i>clay</i>		

WELL LOCATION:
sec. *5* T. *13* N. R. *6* E.
S. *5* miles *SE* of *Osborn*
(distance) (direction) (nearest town)

WELL PURPOSE: *Home*
(home, irrigation, municipal, industrial)

- WELL COMPLETION DATA:
- (1) diameter (inches) *4"*
 - (2) total depth (feet) *360'*
 - (3) static water level (feet) *88'* below above top of ground.
 - (4) casing *steel* *23'*
(material) (depth)
____ if telescope see back.
(size)
 - (5) screen *NONE*
(length) (depth to top)
(size) (material)
 - (6) pump *3/4* *5*
(HP) (yield gpm)
Electric
(type power)
 - (7) electric log *no*
(yes or no)
(organization running log)
 - (8) how well bottom plugged *open*

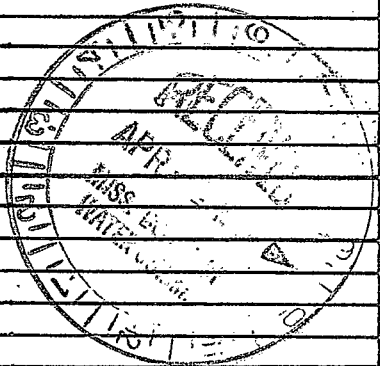

DRILLERS REMARKS:

If well telescopes please sketch and show depths.

GROUND LEVEL

SECTION 5

Please indicate well location X.

ADDITIONAL INFORMATION

If more than one screen,
show locations of each on sketch.