

Monroe
F 2004
3-67

MISSISSIPPI
BOARD OF WATER COMMISSIONERS
416 North State Street
Jackson, Mississippi 39201

WATER WELL DRILLERS LOG *Monroe*

Herndon-Homan Well & Supply, Inc.

3-6 1967
date well completed

P. O. Box 42
SHANNON, MISSISSIPPI 38668
county well located

LANDOWNER:
Joe S. Howell
Egypt, MISSISSIPPI
(mailing address)


description of formations encountered	from	to
<i>Black clay</i>	<i>0</i>	<i>25</i>
<i>Blue clay</i>	<i>25</i>	<i>280</i>
<i>sand</i>	<i>280</i>	<i>400</i>
<i>bottom</i>	<i>400</i>	

WELL LOCATION:
sec *3* T *13* N R *6* E
S
1 miles *E* of *Egypt*
(distance) (direction) (nearest town)

WELL PURPOSE: *TENANT*
(home, irrigation, municipal, industrial)


- WELL COMPLETION DATA:
- (1) diameter (inches) *5"*
 - (2) total depth (feet) *400'*
 - (3) static water level (feet) *122* below top of ground.
 - (4) casing *steel*, *30'10"*
(material) (depth)
5 if telescope see back.
(size)
 - (5) screen *none*
(length) (depth to top)
(size) (material)
 - (6) pump *3/4* *10*
(HP) (yield gpm)
electric
(type power)
 - (7) electric log *NO*
(yes or no)
(organization running log)
 - (8) how well bottom plugged *open*

DRILLERS REMARKS:

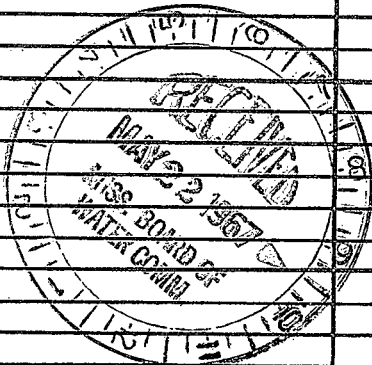

If well telescopes please sketch and show depths.

GROUND LEVEL

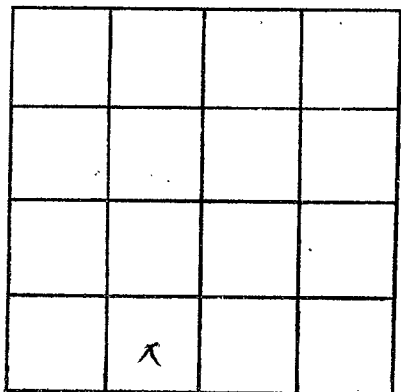

SECTION 31

Please indicate well location X.

ADDITIONAL INFORMATION

If more than one screen,
show locations of each on sketch.