

Monroe
F 2006
8-68

MISSISSIPPI
 BOARD OF WATER COMMISSIONERS
 416 North State Street
 Jackson, Mississippi 39201
 WATER WELL DRILLERS LOG

8-7 1968 *Herndon* *Well & Supply, Inc* *Monroe*
 date well completed firm name county well located
 P. O. Box 42


LANDOWNER:
Jack Gregory
At Okolona, Miss
 (mailing address)

description of formations encountered	from	to
<i>loam clay</i>	0	30
<i>Blue clay</i>	30	540
<i>sand</i>	540	560
<i>Bottom</i>	560	

WELL LOCATION:
 sec. *7* T. *13* S. R. *6* E.
4 1/2 miles *SE* of *Okolona*
 (distance) (direction) (nearest town)

WELL PURPOSE:
Drain
 (home, irrigation, municipal, industrial)

- WELL COMPLETION DATA:
- (1) diameter (inches) *5"*
 - (2) total depth (feet) *560'*
 - (3) static water level (feet) *100'* below top of ground.
 - (4) casing *steel*, *42'4"* (material), (depth)
5" if telescope see back. (size)
 - (5) screen *ND*, (length), (depth to top)
 (size), (material)
 - (6) pump *3/4* (HP), *3* (yield gpm)
electric (type power)
 - (7) electric log *ND* (yes or no)
 (organization running log)
 - (8) how well bottom plugged *open*

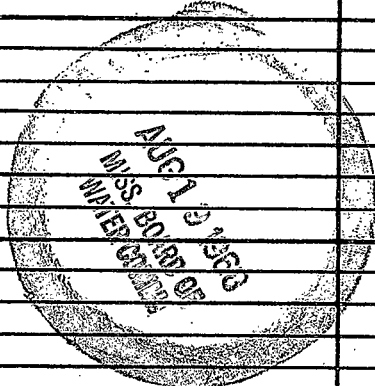

DRILLERS REMARKS:

If well telescopes please sketch and show depths.

GROUND LEVEL

X			

SECTION 7

Please indicate well location X.

ADDITIONAL INFORMATION

If more than one screen,
show locations of each on sketch.