

MONROE
F 7007
4-1-77

MISSISSIPPI
BOARD OF WATER COMMISSIONERS
416 North State Street
Jackson, Mississippi 39201

13L

WATER WELL DRILLERS LOG

4-1-77 date well completed 1977 Herman Homan Well & Supply, Inc. P. O. Box 42
SHANNON MISSISSIPPI 38668 Monroe county well located

LANDOWNER:
Dr. L. R. Murphree
Aberdeen, MS.
(mailing address)

description of formations encountered	from	to
Surface clay	0	35
Blue clay	35	200
Sand	200	340
Bottom	340	

WELL LOCATION:
sec. 27 T. 13 N. R. 6 E
S W
5 miles NW of Aberdeen
(distance) (direction) (nearest town)

WELL PURPOSE: Farm
(home, irrigation, municipal, industrial)

- WELL COMPLETION DATA:
- (1) diameter (inches) 4 1/2
 - (2) total depth (feet) 340
 - (3) static water level (feet) 134 below top of ground.
 - (4) casing (material) steel, 4 1/2" (depth) 340
4 1/2" (size) If telescope see back.
 - (5) screen (length) 20 (depth to top) 20
(size) (material)
 - (6) pump (HP) 1/2 (yield gpm) 5
electric (type power)
 - (7) electric log (yes or no) NO
 - (organization running log)
 - (8) how well bottom plugged open


RECEIVED
MAY 2 1977

DRILLERS REMARKS:

MISS. BD. OF WATER COMMISSIONERS

If well telescopes please sketch and show depths.

GROUND LEVEL

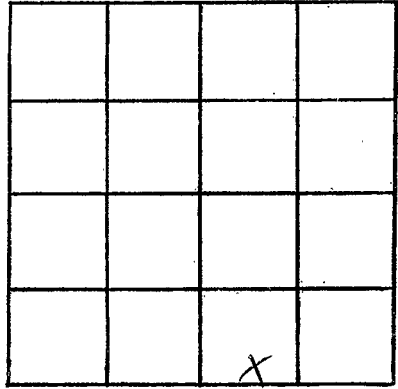

SECTION 27

Please indicate well location X.

ADDITIONAL INFORMATION

If more than one screen, show locations of each on sketch.