

Monroe  
F 2008  
5/18/77

MISSISSIPPI  
 BOARD OF WATER COMMISSIONERS  
 416 North State Street  
 Jackson, Mississippi 39201

13L

WATER WELL DRILLERS LOG

Herman Homan Well & Supply, Inc.

P. O. Box 42

SHANNON, MISSISSIPPI 38868

Monroe  
 county well located

May 18 1977  
 date well completed

LANDOWNER: Liffitch Community Center  
Attn Aberdeen Ms  
 (mailing address)

description of formations encountered:  
 surface clay 0-35  
 blue clay 35-200  
 sand 200-340  
 Bottom 340

WELL LOCATION:  
 sec. 35 T 13 N R. 6 E  
7 miles NW of Aberdeen  
 (distance) (direction) (nearest town)

WELL PURPOSE: church  
 (home, irrigation, municipal, industrial)

WELL COMPLETION DATA:

(1) diameter (inches) 4 1/4

(2) total depth (feet) 340

(3) static water level (feet) 145 below top of ground.

(4) casing steel (material) 41' 6" (depth)  
4" (size) if telescope see back.

(5) screen no (length) (depth to top)  
 (size) (material)

(6) pump sp. 5 (HP) (yield gpm)  
electric (type power)

(7) electric log no (yes or no)  
 (organization running log)

(8) how well bottom plugged open


**RECEIVED**

JUN 1 1977

DRILLERS REMARKS:

If well telescopes please sketch and show depths.

GROUND LEVEL

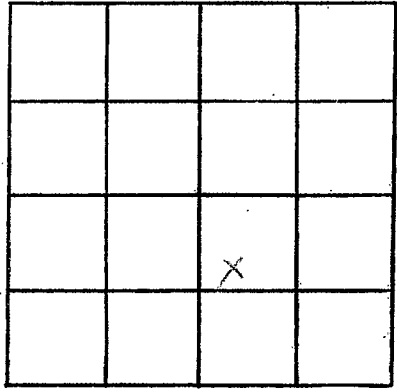

SECTION 35

Please indicate well location X.

ADDITIONAL INFORMATION

If more than one screen,  
show locations of each on sketch.