

Monroe
F 7009
10/20/77

MISSISSIPPI
BOARD OF WATER COMMISSIONERS
416 North State Street
13L Jackson, Mississippi 39201

WATER WELL DRILLERS LOG

Herman Homan Well & Supply, Inc.

P. O. Box 42

SHANNON, MISSISSIPPI 38868

Monroe

10/20/77
date well completed

county well located

LANDOWNER:

Bobby Griffin

At (Deborah) Mrs.
(mailing address)

description of formations
encountered

from to

subsoil		
clay	0	30
blue clay	33	120
sand	120	200
bottom	200	

WELL LOCATION:

sec. 12 T. 13 N R. 6 E
S W
1 miles W of New Wre
(distance) (direction) (nearest town)

WELL PURPOSE: Home
(home, irrigation, municipal, industrial)

WELL COMPLETION DATA:

- (1) diameter (inches) 4"
- (2) total depth (feet) 200
- (3) static water level (feet) 10 below top of ground.
- (4) casing steel 36'6"
(material) (depth)
- 4"
(size) if telescope see back.
- (5) screen no
(length) (depth to top)
- (size) (material)
- (6) pump 1/2 5
(HP) (yield gpm)
- electric
(type power)
- (7) electric log no
(yes or no)

(organization running log)

(8) how well bottom plugged SPW


DRILLERS REMARKS:

RECEIVED
OCT 28 1977

MISS. BD. OF WATER COMMISSIONERS

If well telescopes please sketch and show depths.

GROUND LEVEL

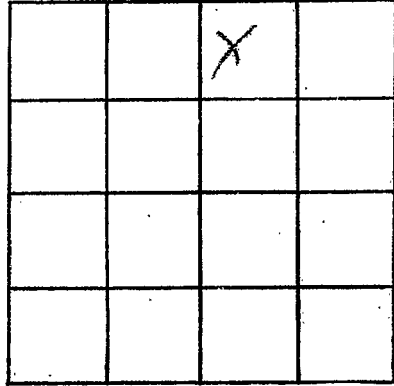

SECTION _____

Please indicate well location X.

12

ADDITIONAL INFORMATION

If more than one screen, show locations of each on sketch.