

MONROE

F 2010

4-17-78

MISSISSIPPI BOARD OF WATER COMMISSIONERS
416 North State Street
Jackson, Mississippi 39201

WATER WELL DRILLERS LOG

4-17
date well completed

19 78 Herman Homan Well & Supply, Inc.

firm name
SHANNON MISSISSIPPI 38868

Monroe
county well located

LANDOWNER:

Walker Donald
Rt #3 Aberdeen MS.
(mailing address)

description of formations encountered

from to

surface clay 0 28
blue clay 28 200
sand 200 320
bottom 320

WELL LOCATION:

sec. 20 T 13 N R 6 E
S W
10 miles N of PRATIC
(distance) (direction) (nearest town)

WELL PURPOSE: Home
(home, irrigation, municipal, industrial)

WELL COMPLETION DATA:

- (1) diameter (inches) 4 1/2"
- (2) total depth (feet) 320'
- (3) static water level (feet) 136' below top of ground
- (4) casing steel 33' (material) (depth)
4 1/2" (size) If telescope see back.
- (5) screen ND (length) (depth to top)
(size) (material)
- (6) pump 1/2 HP 5 (yield gpm)
electric (type power)
- (7) electric log NO (yes or no)
(organization running log)
- (8) how well bottom plugged open


RECEIVED
JUN - 6 1978

DRILLERS REMARKS:

MISS. BD. OF WATER COMM

If well telescopes please sketch and show depths.

GROUND LEVEL

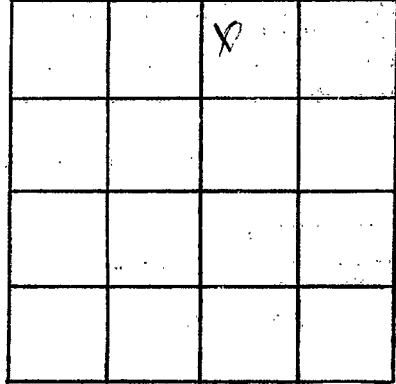

SECTION 20

Please indicate well location X.

ADDITIONAL INFORMATION

If more than one screen, show locations of each on sketch.