

MONROE
F 2012

**MISSISSIPPI  
BOARD OF WATER COMMISSIONERS**  
416 North State Street  
Jackson, Mississippi 39201

**WATER WELL DRILLERS LOG**

Herman Homan Well & Supply, Inc.  
P. O. Box 42

6/30 1978  
date well completed

SHANNON, MISSISSIPPI 38666

Monroe  
county well located


**LANDOWNER:**  
Brent Allen  
Rt 1, Okolona, Ms.  
(mailing address)

description of formations encountered	from	to
surface sand		
+ clay	0	25
blue clay	25	180
sand	180	320
Bottom	320	

**WELL LOCATION:**  
sec. 11 T. 13 N R. 6 E  
1 3/4 miles W of New Wren  
(distance) (direction) (nearest town)

**WELL PURPOSE:** Home  
(home, irrigation, municipal, industrial)

- WELL COMPLETION DATA:**
- diameter (inches) 5"
  - total depth (feet) 320'
  - static water level (feet) 192' below top of ground
  - casing (material) steel, (depth) 41' 10"  
5" (size) if telescope see back.
  - screen (length) NO (depth to top)
  - pump (HP) 1/2 (material) S (yield gpm)  
electron (type power)
  - electric log NO (yes or no)
  - (organization running log)
  - how well bottom plugged open

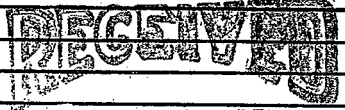


AUG 3 1978

**DRILLERS REMARKS:**

MISS. BD. OF WATER COMMISSIONERS

If well telescopes please sketch and show depths.

GROUND LEVEL

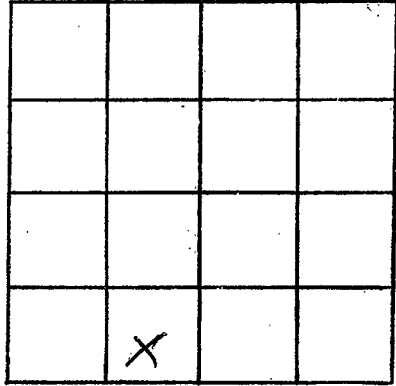

SECTION 11

Please indicate well location X.

ADDITIONAL INFORMATION

If more than one screen, show locations of each on sketch.