

MONROE
 F 2013
 8-17-78

MISSISSIPPI
 BOARD OF WATER COMMISSIONERS
 416 North State Street
 Jackson, Mississippi 39201

WATER WELL DRILLERS LOG

W. M. N. HUMAN WELL & SUPPLY, INC.

8-17 1978 BY firm name Monroe
 date well completed county well located

LANDOWNER:
Lorena Sims
At: A. Woodard Mrs.
 (mailing address)

description of formations encountered	from	to
500 Ecu sand	0	18
+ clay		
Blue clay	18	85
sand	85	220
Rock	220	

WELL LOCATION:
 sec. 9 T. 13 N. R. 6 E
7 miles E of Ardmore
 (distance) (direction) (nearest town)

WELL PURPOSE: Home
 (home, irrigation, municipal, industrial)

WELL COMPLETION DATA:

(1) diameter (inches) 4"

(2) total depth (feet) 220"

(3) static water level (feet) 105' below top of ground.

(4) casing Steel 21'5"
 (material) (depth)

4" if telescope see back.
 (size)

(5) screen 20
 (length) (depth to top)

 (size) (material)

(6) pump 1/2 5
 (HP) (yield gpm)

electric
 (type power)

(7) electric log NO
 (yes or no)

 (organization running log)

(8) how well bottom plugged Open


DRILLERS REMARKS:

RECEIVED
 SEP 15 1978

MISS. BOARD OF WATER COMMISSIONERS

If well telescopes please sketch and show depths.

GROUND LEVEL

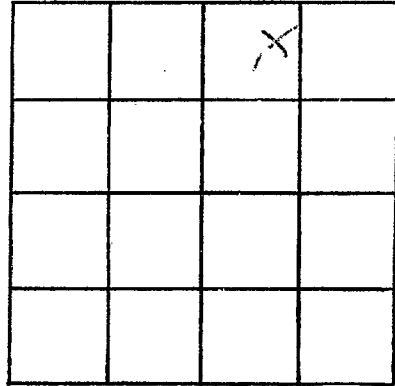

SECTION 9

Please indicate well location X.

ADDITIONAL INFORMATION

If more than one screen,
show locations of each on sketch.