

MONROE
F 2014
9-29-78

**MISSISSIPPI  
BOARD OF WATER COMMISSIONERS**  
416 North State Street  
Jackson, Mississippi 39201

**WATER WELL DRILLERS LOG**  
Herman Homan Well & Supply, Inc.

P. O. Box 42

8-29 1978      SHANNON, MISSISSIPPI      *Madison*  
date well completed      name      county well located

**LANDOWNER:**  
*David McGhee*  
*At 3 Aberdeen Ms*  
(mailing address)

description of formations encountered	from	to
<i>surface</i>	<i>0</i>	<i>28</i>
<i>yellow clay</i>	<i>0</i>	<i>160</i>
<i>sand</i>	<i>160</i>	<i>200</i>
<i>bottom</i>	<i>300</i>	

**WELL LOCATION:**  
sec *35* T *13* N R *6* E  
*5* miles *NW* of *Aberdeen*  
(distance) (direction) (nearest town)

**WELL PURPOSE:** *Home*  
(home, irrigation, municipal, industrial)

**WELL COMPLETION DATA:**

(1) diameter (inches) *8 1/2*

(2) total depth (feet) *300*

(3) static water level (feet) *124* below/above top of ground.

(4) casing *steel* (material) *25 1/2* (depth)  
*5 1/2* (size) if telescope see back.

(5) screen *no* (length) (depth to top)  
(size) (material)

(6) pump *3/4* (HP) *7* (yield gpm)  
*electric* (type power)

(7) electric log *no* (yes or no)  
(organization running log)

(8) how well bottom plugged *open*


**DRILLERS REMARKS:**

**RECEIVED**  
NOV - 3 1978

MISS. BD. OF WATER COMMISSIONERS

If well telescopes please sketch and show depths.

GROUND LEVEL

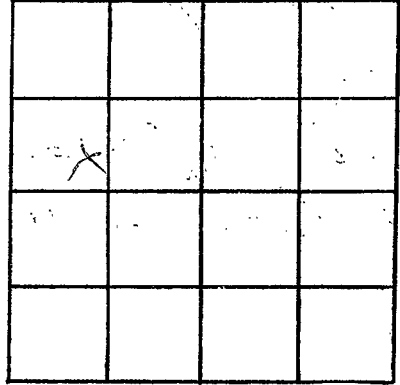

SECTION 35

Please indicate well location X.

ADDITIONAL INFORMATION

If more than one screen, show locations of each on sketch.