

MISSISSIPPI DEPARTMENT OF NATURAL RESOURCES

Bureau of Land and Water Resources

Southport Mall

P.O. Box 10631

Jackson, Mississippi 39209

WATER WELL DRILLERS LOG

Monroe
F
2015

July 22 1983 date well completed
CARENCE firm name
Monroe county/well located

LANDOWNER: Chandler
RT 2
ABERDEEN, MS
(mailing address)

WELL LOCATION:
sec. 8 T. 13 N. R. 6 E.
8 miles SE of OKOLONA
(distance) (direction) (nearest town)

WELL PURPOSE: Home
(home, irrigation, municipal, industrial)

WELL COMPLETION DATA:
(1) diameter (inches) 6"
(2) total depth (feet) 320
(3) static water level (feet) 150 below top of ground
(4) casing PVC 50' (material) (depth)
6" (size) if telescope see back.
(5) screen None (length) (depth to top)
(size) (material)
(6) pump 3/4 5 (HP) (yield gpm)
Electric (type power)
(7) electric log NO (yes or no)
(organization running log)
(8) how well bottom plugged OPEN


description of formations encountered	from	to
Top Gumbo	0	15
Blue Clay	15	160
CHALK	160	210
Shale	210	320

DRILLERS REMARKS:
Very Low Yield

DEPT. OF NATURAL RESOURCES
BUREAU OF LAND & WATER RESOURCES
NOV 29 1984
RECEIVED

If well telescopes please
sketch and show depths.

GROUND LEVEL

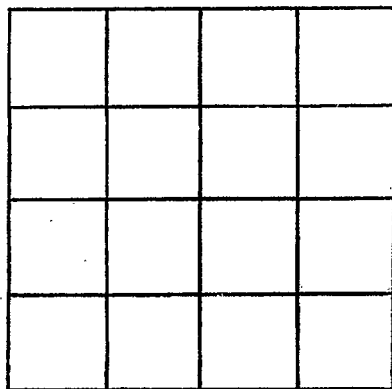

SECTION _____

Please indicate well location X.

ADDITIONAL INFORMATION

If more than one screen,
show locations of each on sketch.