

monroe

Elev # 46

~~621~~ 3-66

WATER WELL DRILLERS LOG

CODED

Date: Mar. 15, 1966 Driller: Sam Smith County Monroe  
(Name)

- (1) Owner of Land: Waters Dist.  
(Name)
- (2) Location: 5<sup>1</sup>/<sub>2</sub> SE 1/4, SE 1/4, Sec. 6 T13<sup>S</sup> R7<sup>E</sup>  
(Address)  
4 miles West of Amory  
(distance) (direction) (Nearest Town)
- (3) Topography: ✓  
(Hilly) (Flat) (Level)
- (4) Purpose of Well: Municipal  
(Domestic Irrigation, Municipal, Industrial, Other)

Description & Color of Materials Sand, Clay, Red Clay, Shell, etc.	Thick- ness Feet	Depth Feet
<u>0-20 Blue Gumbo</u>		
<u>20-40 "</u>		
<u>40-60 Bone R + Clay</u>		
<u>60-80 Sand R + clay</u>		
<u>80-100 Shale + sand</u>		
<u>100-120 " + sand</u>		
<u>120-140 Shale + sand</u>		
<u>140-150 Shale + sand</u>		
<u>150-160 fine Blk. + white s.s.</u>		

Under beam at 20  
Information upon completion of well:

- (1) Diameter 8" inches.
- (2) Total Depth 280 feet.
- (3) Water Level 80 feet below top of ground.
- (4) Cased to 216, Size 8"
- (5) Screen: Size 4", Length 20 ft
- (6) Were any formations sealed against pollution?  
\_\_\_\_\_ yes, \_\_\_\_\_ no.


Description & Color of Materials Sand, Clay, Red Clay, Shell, etc.	Thick- ness Feet	Depth Feet
<u>210-224 Sh. + Clay</u>		
<u>224 to bottom Shale</u>		
<u>224 to 275 Sand</u>		
<u>275- Sh + Clay</u>		

CODED

If YES, depth of formation \_\_\_\_\_

Why \_\_\_\_\_

Drillers Remarks: \_\_\_\_\_

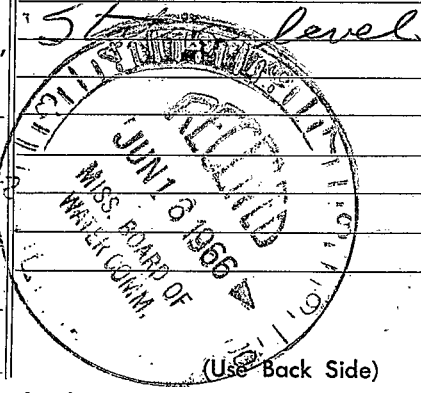

Well No.

(X)