

MONROE
 G 23
 4-7-70

MISSISSIPPI
 BOARD OF WATER COMMISSIONERS
 416 North State Street
 Jackson, Mississippi 39201

CODED

WATER WELL DRILLERS LOG

8-7 1970 W.J. REEVES & SON MONROE
 date well completed firm name county well located

LANDOWNER: J.B. ARMSTRONG

BECKER

2568148

(mailing address)

description of formations encountered	from	to
SANDY CLAY	0	17
SAND & GRAVEL	17	39

WELL LOCATION:

sec. 23 T 13 R 19 E
 2 miles SW of BECKER
 (distance) (direction) (nearest town)

WELL PURPOSE: HOME
 (home, irrigation, municipal, industrial)

WELL COMPLETION DATA:

- (1) diameter (inches) 2
- (2) total depth (feet) 39
- (3) static water level (feet) 12 below top of ground.
- (4) casing PVC 33 (material) (depth)
- (size) 2 If telescope see back.
- (5) screen 6 33 (length) (depth to top)
- (size) 2 PVC (material)
- (6) pump NONE (HP) (yield gpm)

CODED

(type power)

(7) electric log No (yes or no)

(organization running log)

(8) how well bottom plugged SAND


AUG 20 1970

DRILLERS REMARKS:

MISS. BD. OF WATER COMMISSIONERS

If well telescopes please sketch and show depths.

GROUND LEVEL

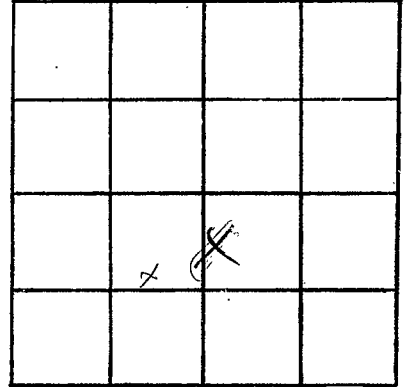

SECTION 23

Please indicate well location X.

ADDITIONAL INFORMATION

If more than one screen, show locations of each on sketch.