

MONROE

MISSISSIPPI BOARD OF WATER COMMISSIONERS

G25

8-3-61

WATER WELL DRILLERS LOG  
HERNDON WELL & SUPPLY CO.

**CODED** 301

Date: 8/3, 1961, Driller: SHANNON P. O. BOX 42 County Monroe  
MISSISSIPPI  
1st house Past Church on left

(1) Owner of Land: <u>Walter E. Godwin</u> <u>HW 45 2568703</u> <u>At 1 Aberdeen, Miss</u> (Name) (Address)	Description & Color of Materials Sand, Clay, Red Clay, Shell, etc.	Thick- ness Feet	Depth Feet
(2) Location: <u>NE SW SE</u> <u>18</u> <u>30</u> <u>133</u> <u>18</u> <u>7</u> 1/4, 1/4, Sec <u>30</u> T. <u>R 7</u> <u>8</u> miles <u>North</u> , of <u>Aberdeen</u> (distance) (direction) (Nearest Town)	<u>surface sand</u> <u>&amp; clay</u>		<u>0</u>
(3) Topography: <u>Hilly</u> (Hilly) (Flat) (Level)	<u>Blue bank</u>		<u>18</u>
(4) Purpose of Well: <u>Domestic</u> (Domestic Irrigation Municipal, Industrial, Other)	<u>Soad</u>		<u>120</u>
	<u>Bottom</u>		<u>240</u>

Information upon completion of well:

(1) Diameter 4 inches.

(2) Total Depth 240 feet.

(3) Water Level 80 feet below top of ground.

(4) Cased to 22' 6", Size 4"

(5) Screen: Size \_\_\_\_\_, Length \_\_\_\_\_

(6) Were any formations sealed against pollution?


✓ yes, \_\_\_\_\_ no.

If YES depth of formation 18 ft.

Why Surface Soad

Drillers Remarks:

**CODED**

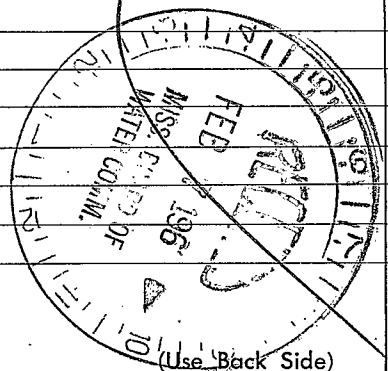

Well No.

