

MONROE

MISSISSIPPI BOARD OF WATER COMMISSIONERS

G26

4-23-65

WATER WELL DRILLERS LOG

CODED

Herdon-Homan Well & Supply, Inc.

Date: April 28, 1965 Driller: P. O. Box 42 County Monroe

SHANNON, MISSISSIPPI 38868

near Carl 4th house on left

(1) Owner of Land: JWA Patten
 (Name)
1 Aberdeen, Miss
 (Address)

(2) Location: SE 1/4, SE 1/4, Sec. 19, T. 13 S, R. 7 E
 (distance) 6 miles NW, of Aberdeen
 (direction) (Nearest Town)

(3) Topography: Flat
 (Hilly) (Flat) (Level)

(4) Purpose of Well: Domestic
 (Domestic Irrigation
 Municipal, Industrial, Other)

Description & Color of Materials Sand, Clay, Red Clay, Shell, etc.	Thick- ness Feet	Depth Feet
<u>uniform sand & clay</u>		<u>0-20</u>
<u>Blue clay</u>		<u>20-30</u>
<u>sand</u>		<u>30-135</u>
<u>Blue clay</u>		<u>135-145</u>
<u>sand</u>		<u>145-260</u>
<u>Bottom</u>		<u>260</u>

Information upon completion of well:

(1) Diameter 4 inches.

(2) Total Depth 260 feet.

(3) Water Level 70 feet below top of ground.

(4) Cased to 140', Size 4"

(5) Screens: Size —, Length —


(6) Were any formations sealed against pollution?
 yes, — no.

If YES depth of formation 135'

Why surface & sand

Drillers Remarks:

CODED

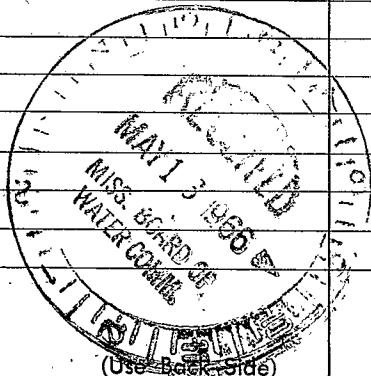

Retain this copy for your office files.

Well No.

1912

1912

1. 1912
 2. 1912
 3. 1912
