

MONROE

G27  
7-67

MISSISSIPPI BOARD OF WATER COMMISSIONERS

**CODED**

**WATER WELL DRILLERS LOG**

Date: July 31, 1967, Driller: Herndon-Homan Well & Supply, Inc. County Monroe  
(When well drilled) ROY CRUMP 320 HOUSE ON RT. P. O. Box 42 Name SHANNON MISSISSIPPI 38868 (Where well is located)

1) Owner of Land:	Description & Color of Materials (Sand, Clay, Red Clay, Shell, etc.)	Thick- ness Feet	Depth Feet
<u>Calvin Coptoad</u> (Name) <u>3 Aberdeen</u> (Address)	<u>surface sand &amp; clay</u>	<u>0</u>	<u>75</u>
2) Location: <u>SE 1/4, NE 1/4, Sec. 30, T. 13S, R. 7E</u>	<u>other clay</u>	<u>75-120</u>	<u>120-240</u>
<u>6</u> miles <u>N</u> of <u>Aberdeen</u> (distance) (direction) (Nearest Town)	<u>sand</u>	<u>120</u>	<u>240</u>
3) Topography: <u>Flat</u> (Hilly) (Flat) (Level)	<u>soil</u>	<u>240</u>	
4) Purpose of Well: <u>Home</u> (Domestic Irrigation Municipal, Industrial, Other)			

Information upon completion of well:

- 1) Diameter 4 inches.
- 2) Total Depth 240 feet.
- 3) Water Level 50' feet below top of ground.
- 4) Cased to 79 1/2", Size 4".
- 5) Screen: Size 10/32, Length \_\_\_\_\_.
- 6) Were any formations sealed against pollution?  
 yes, \_\_\_\_\_ no.

YES depth of formation 75


Why Surface & sand

Drillers Remarks: \_\_\_\_\_

Yield in gpm: 5

Size pump: 3/4

Type power: electric

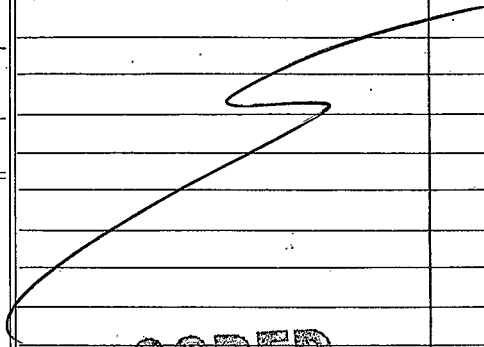

**CODED**

