

Monroe  
 G 29  
 6-68

MISSISSIPPI  
 BOARD OF WATER COMMISSIONERS  
 416 North State Street  
 Jackson, Mississippi 39201

**CODED**

WATER WELL DRILLERS LOG

6-10-68 Herndon-Homan Well & Supply, Inc. Monroe  
 date well completed 1968 Pm On Box 42 county well located  
 Cr. 3<sup>rd</sup> house on N Lett SEANNON, MISSISSIPPI 38662



LANDOWNER: Carl Hale  
L. C. Cook (cont)  
RA1, A bender, Miss  
 (mailing address)

description of formations encountered	from	to
<u>Super Sand</u>		
<u>Blue clay</u>	<u>0.65</u>	<u>1.00</u>
<u>Sand</u>	<u>1.20</u>	<u>1.40</u>
<u>Clay</u>		

WELL LOCATION:  
 sec 30 T 13 N R 7 E  
S W  
3 1/2 miles South of Ward  
 (distance) (direction) (nearest town)

WELL PURPOSE: Home  
 (home, irrigation, municipal, industrial)

- WELL COMPLETION DATA:
- (1) diameter (inches) 4"
  - (2) total depth (feet) 240'
  - (3) static water level (feet) 53' below above top of ground.
  - (4) casing Steel 72' 4"  
 (material) (depth)  
4" if telescope see back:  
 (size)
  - (5) screen NO (length) (depth to top)  
 (size) (material)
  - (6) pump 3/4 5  
 (HP) (yield gpm)  
elect  
 (type power)
  - (7) electric log NO (yes or no)  
 (organization running log)
  - (8) how well bottom plugged open

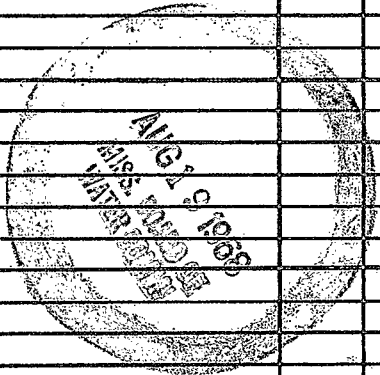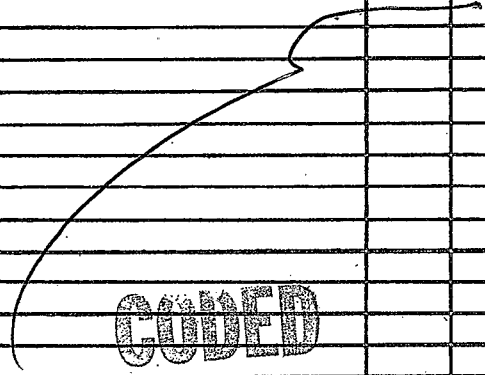

DRILLERS REMARKS:

If well telescopes please sketch and show depths.

GROUND LEVEL

			X
			X

SECTION 30

Please indicate well location X.

ADDITIONAL INFORMATION

If more than one screen, show locations of each on sketch.