

MONROE

B631

1-65

MISSISSIPPI BOARD OF WATER COMMISSIONERS

CODED

WATER WELL DRILLERS LOG

Herndon-Homan Well & Supply, Inc.

Date: Jan, 28, 1965, Driller: P. O. Box 42 County Monroe

5th House on Left

(1) Owner of Land: Ellis L. Wood (Name)

At 1 Aberdeen Miss (Address)

SE 1/4, SE 1/4, Sec. 5 T. 13 S. R. 7 E

6 miles W. of Amory (distance) (direction) (Nearest Town)

(3) Topography: Flat (Hilly) (Flat) (Level)

(4) Purpose of Well: Domestic (Domestic Irrigation Municipal, Industrial, Other)

Description & Color of Materials Sand, Clay, Red Clay, Shell, etc.	Thick- ness Feet	Depth Feet
Top Soil	0	40
Blue clay	40	240
240 ft to 320 ft	240	320
Bottom	320	

Information upon completion of well:

(1) Diameter 4 inches.

(2) Total Depth 320 feet.

(3) Water Level 110 feet below top of ground.

(4) Cased to 220', Size 4" / 2"

(5) Screen: Size 2", Length 20'

(6) Were any formations sealed against pollution?


yes, no.

If YES depth of formation 40

Why: Sand & sand

Drillers Remarks: This a screen well 20ft screen

CODED

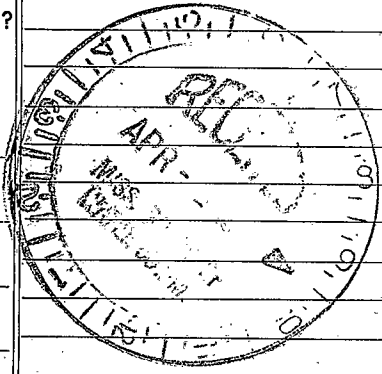

Retain this copy for your office files.

(Use Back Side)

Well No.

