

MONROE
G-39

WATER WELL DRILLERS LOG

CODED?

Herndon Well & Supply Co. Monroe

Date: Feb 14, 1961, Driller: SHANNON

2-14-61 255-13 WELL FILLED UP WITH SAND

(1) Owner of Land: Tom Pace
 (Name)
 Coontail Rd.
 256 8746 Aberdeen, Miss
 (Address)

(2) Location: SW SW SW
 1/4, 1/4, Sec. 21 T13R7,
4 miles North, of Aberdeen
 (distance) (direction) (Nearest Town)

(3) Topography: Flat
 (Hilly) (Flat) (Level)

(4) Purpose of Well: Home use
 (Domestic Irrigation
 Municipal, Industrial, Other)

Description & Color of Materials Sand, Clay, Red Clay, Shell, etc.	Thick- ness Feet
<u>Sand & clay</u>	<u>46</u>
<u>Bl. Shell</u>	<u>60</u>
<u>SAND</u>	<u>63</u>
<u>Bottom</u>	<u>168</u>

Information upon completion of well:

(1) Diameter 4 inches.

(2) Total Depth 168 feet.

(3) Water Level 50 feet below top of ground.

(4) Cased to 43' 9", Size 4"

(5) Screen: Size , Length


(6) Were any formations sealed against pollution?
 yes, no.

If YES depth of formation 40 ft

Why Surface & Sand

Drillers Remarks:

CODED

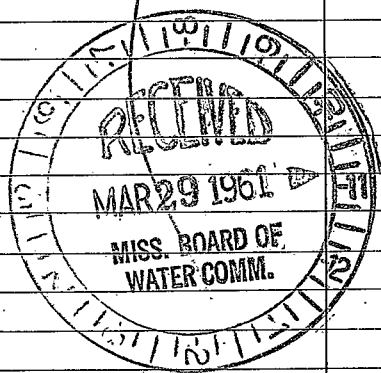

(Use Back Side)

Well No.

