

MONROE

MISSISSIPPI BOARD OF WATER COMMISSIONERS

CODED

WATER WELL DRILLERS LOG

G-35

4-18-61

Date: 4-18, 1961, Driller: J.C. KEEVES County MONROE

255-3,7. WELL NOT IN USE ON WATER SYSTEM

(Name)

Coontail Rd. 256 2250

(1) Owner of Land: ISOBBY CLARK (Name)

RT. 1, ABERDEEN, MISS. (Address)

E 1/2 SE NW (2) Location: 1/4, 1/4, Sec. 20 T.13R.7,

7 miles NORTH, of ABERDEEN (distance), (direction) (Nearest Town)

(3) Topography: HILLY (Hilly) (Flat) (Level)

(4) Purpose of Well: DOMESTIC (Domestic Irrigation Municipal, Industrial, Other)

Description & Color of Materials Sand, Clay, Red Clay, Shell, etc.	Thick- ness Feet	Depth Feet
CLAY	18	0
RED SAND	23	18
BLUE CLAY	34	41
" SAND	18	75
" CLAY	21	93
" SAND	46	114

Information upon completion of well:

(1) Diameter 4 inches.

(2) Total Depth 160 feet.

(3) Water Level 55 feet below top of ground.

(4) Cased to 45', Size 4"

(5) Screen: Size _____, Length _____.


(6) Were any formations sealed against pollution?
_____ yes, _____ no.

If YES depth of formation _____

Why _____

Drillers Remarks: _____

CODED

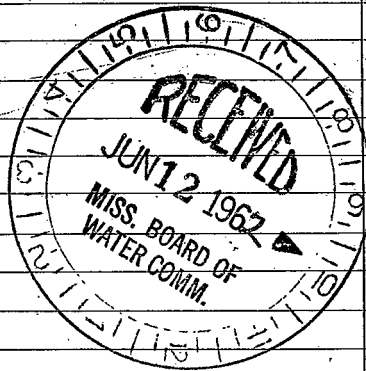

(Use Back Side)

Well No.

