

640
11-17-60

WATER WELL DRILLERS LOG

CODED H 300

Date: 11-17, 1960, Driller: W. J. REEVES & SON County: MONROE

(Name)

932-8
934-3 1036-12

(1) Owner of Land: EC. BOURLAND
(Name)

AMORY, Miss-
(Address)

214 3105,
256 5327

(2) Location: NE 1/4, SW 1/4, Sec. 2 T13S R17W

1 miles S of AMORY
(distance) (direction) (Nearest Town)

(3) Topography: FLAT
(Hilly) (Flat) (Level)

(4) Purpose of Well: DOMESTIC
(Domestic Irrigation
Municipal, Industrial, Other)

Information upon completion of well:

(1) Diameter 2 1/2 inches.

(2) Total Depth 28 feet.

(3) Water Level 10 feet below top of ground.

(4) Cased to 23', Size 2 1/2"

(5) Screen: Size 2 1/2", Length 5'

(6) Were any formations sealed against pollution?

yes, no.

If YES depth of formation

Why

Drillers Remarks:

Description & Color of Materials
Sand, Clay, Red Clay, Shell, etc.

Thick-
ness
Feet

Depth
Feet

CLAY

12


0

SAND & GRAVEL

16

12

CODED

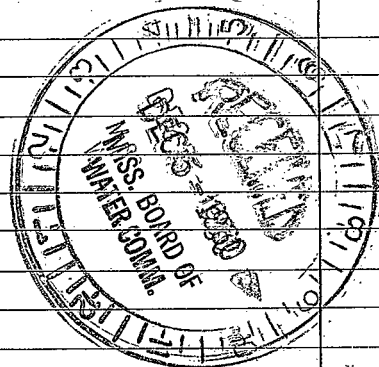

(Use Back Side)

Well No.

