

MONROE
G43

MISSISSIPPI
BOARD OF WATER COMMISSIONERS
416 North State Street
Jackson, Mississippi 39201

CODED

WATER WELL DRILLERS LOG

July 17, 1972 Herndon Well & Supply Co. Monroe
date well completed firm name county well located

LANDOWNER:
Bobby Griffin

description of formations
encountered

from to

White Chalk

0 15

Wren Community
Aberdeen, Ms.

Blue Rock

15 105

Sand

105 340

(mailing address)

WELL LOCATION:

sec. 12 T13S N R7E E
S W

Wren Community

(distance) miles (direction) of (nearest town)

WELL PURPOSE: home

(home, irrigation, municipal, industrial)

WELL COMPLETION DATA:

- (1) diameter (inches) 5"
(2) total depth (feet) 340'
(3) static water level (feet) 75 below above
top of ground.

- (4) casing steel 20'
(material) (depth)
5"
(size) if telescope see back.

- (5) screen (length) (depth to top)
(size) (material)

- (6) pump 1/2 Sub. 10
(HP) (yield gpm)
elec
(type power)

- (7) electric log no
(yes or no)

(organization running log)

- (8) how well bottom plugged open

CODED


APR 21 1972
APR 21 1972

MISS. BO. OF
WATER COMMISSIONERS

DRILLERS REMARKS:

If well telescopes please sketch and show depths.

GROUND LEVEL

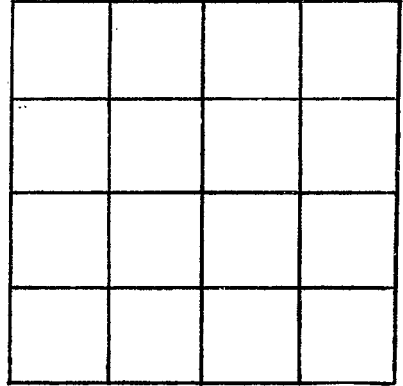

SECTION _____

Please indicate well location X.

ADDITIONAL INFORMATION

If more than one screen, show locations of each on sketch.