

MON ROE  
 G 44  
 9/27/74

MISSISSIPPI  
 BOARD OF WATER COMMISSIONERS  
 416 North State Street  
 Jackson, Mississippi 39201

CODED

WATER WELL DRILLERS LOG

9-27 1974 N. J. REEVES & SON MONROE  
 date well completed firm name county well located

LANDOWNER: BOURLAND FARM  
AMORY

description of formations encountered	from to	
	feet	feet
RED CLAY	0	14
WHITE SAND	14	18
RED CLAY	18	21
SAND & GRAVEL	21	32
RED SAND	32	54

(mailing address)

WELL LOCATION:  
 sec. 2 T. 13 S. R. 19 E. (W)  
1 miles SW of AMORY  
 (distance) (direction) (nearest town)

CODED

WELL PURPOSE: HOME  
 (home, irrigation, municipal, industrial)

WELL COMPLETION DATA:

- (1) diameter (inches) 4
- (2) total depth (feet) 54
- (3) static water level (feet) 20 below top of ground.
- (4) casing PVC, 34,  
 (material) (depth)  
4 if telescope see back.  
 (size)
- (5) screen 20, 34  
 (length) (depth to top)  
4, PVC  
 (size) (material)
- (6) pump 1/2, 10  
 (HP) (yield gpm)  
ELECT  
 (type power)
- (7) electric log NO  
 (yes or no)

(organization running log)


(8) how well bottom plugged SAND

DRILLERS REMARKS:

DEPT. OF WATER COMM.  
 OCT 24 1974

If well telescopes please sketch and show depths.

GROUND LEVEL

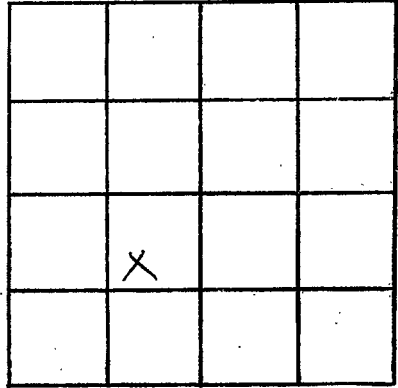

SECTION 2

Please indicate well location X.

ADDITIONAL INFORMATION

If more than one screen, show locations of each on sketch.