

MONROE
650
10/19/74

MISSISSIPPI
BOARD OF WATER COMMISSIONERS CODED
416 North State Street
Jackson, Mississippi 39201

WATER WELL DRILLERS LOG

Herman Homan Well & Supply, Inc.
P.O. Box 47
SHANNON, MISSISSIPPI 38668

10/19 1974 date well completed
MONROE county well located

LANDOWNER: Mose Hardy
Church
Rt 1, Abbeville, Miss.
(mailing address)

description of formations encountered	from	to
Surface sand & clay	0	7.2
Blue clay	7.2	8.5
Sand	8.5	20.0
Bottom	20.0	

WELL LOCATION:
sec 28 T 13 N R 7 E
S W
3 miles S of Wavel
(distance) (direction) (nearest town)

WELL PURPOSE: Church
(home, irrigation, municipal, industrial)


- WELL COMPLETION DATA:
- (1) diameter (inches) 4"
 - (2) total depth (feet) 200'
 - (3) static water level (feet) 58' below above top of ground.
 - (4) casing Steel 84'
(material) (depth)
4" if telescope see back.
(size)
 - (5) screen ND
(length) (depth to top)
(size) (material)
 - (6) pump 3/4 5
(HP) (yield gpm)
electric
(type power)
 - (7) electric log ND
(yes or no)
(organization running log)
 - (8) how well bottom plugged open

RECEIVED
NOV 18 1974
MISS. BD. OF WATER COMMISSIONERS

DRILLERS REMARKS:

If well telescopes please sketch and show depths.

GROUND LEVEL

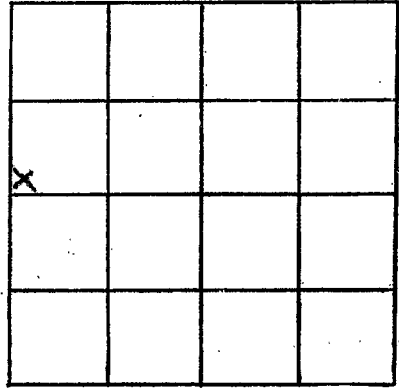

SECTION 29

Please indicate well location X.

ADDITIONAL INFORMATION

If more than one screen, show locations of each on sketch.